U.S. PUBLIC LAND SURVEY MONUMENT RECORD

Note: This form is intended and designed to fulfill all requirements of Wisconsin Administrative Code, Chapter A-E 5.02, U.S. Public Land Survey Monument Record (3) (a) (b) (c) (d) (e) (f) (g) (h) (i). An additional sheet may be added if necessary to conform with said requirements.

(a) Corner location: Township 39 North

Range 7 East

Town/~~City/Village~~ Woodruff

County Oneida

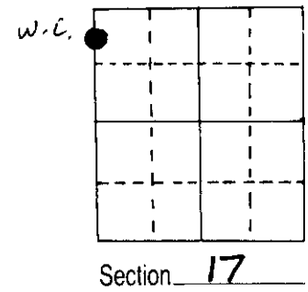

Section 17

(b) (f) (g) (h) Description of monument found at this corner and if it was accepted, state all evidence (material, testimonial, occupational, plats, records, other monuments) used as a basis for accepting. If not accepted or if nothing was found, state evidence used as basis for establishing location. If reestablished through lost corner proportionate methods, indicate all monuments, distances and directions used to establish.

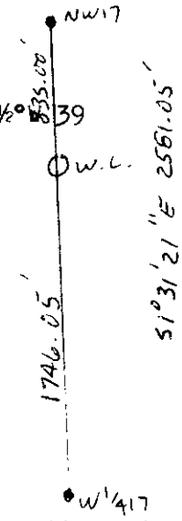

Original by Alex Anderson, 1863, OBT's BW 10" S42°E 31 lks., PW 12" S 25½°E
orig. was 12.61 ch. south of NW 17.
(832.26')

No evidence of original (location now falls in water.)

Seymour, 1984, set witness cor. monument on south shore of Hemlock L. at 835.00' south of NW 17.

This tie sheet should have been sent along with the rest of the Township corner sheets, but it was either misplaced or forgotten.

(c) (d) (e) Plan view of corner with ties to at least 4 witness monuments. If in disagreement with previously established corner, show the distances between the two corners and also indicate the ties to the disputed corner.

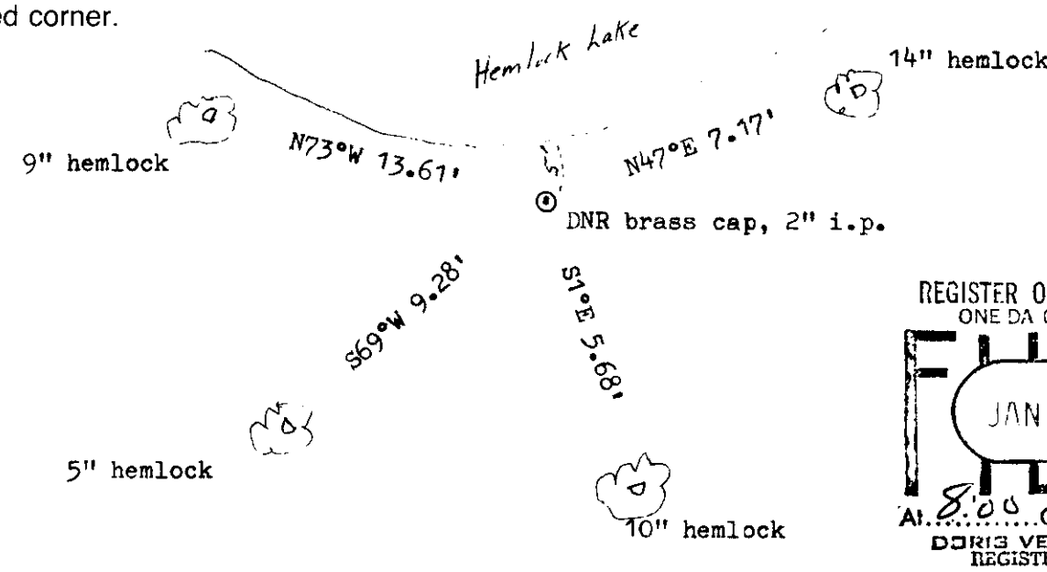

REGISTER OF DEEDS OFFICE
ONEIDA COUNTY, WIS.
FILED
JAN 1 3 19[illegible]
At 8:00 O'Clock a M
DORIS VERAGE KUEHN
REGISTER OF DEEDS

(i) I, Marvin E. Seymour (type or print name) certify that the corner location on this record was determined by me or under my direction and control and that this U.S. Public Land Survey Monument Record is correct and complete to the best of my knowledge and belief.

Affix seal here

WISCONSIN
MARVIN E. SEYMOUR
S-1412
WOODRUFF, WIS.
LAND SURVEYOR

Marvin E. Seymour — Jan 6, 1988

Signature — Date

TK-5

3907183800