


U.S. PUBLIC LAND SURVEY MONUMENT RECORD

Note: This form is intended and designed to fulfill all requirements of Wisconsin Administrative Code, Chapter A-E 5.02, U.S. Public Land Survey Monument Record (3) (a) (b) (c) (d) (e) (f) (g) (h) (i). An additional sheet may be added if necessary to conform with said requirements.

(a) Corner location: Township 39 North
 Range 7 East ~~West~~

Town ~~City/Village~~ of Woodruff
 County Oneida

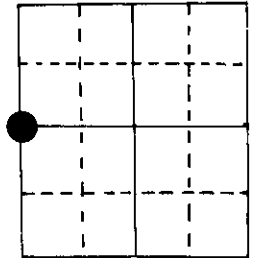


W¹/₄ Section 21

2" iron pipe with D.N.R. brass cap

(b) (f) (g) (h) Description of monument found at this corner and if it was accepted, state all evidence (material, testimonial, occupational, plats, records, other monuments) used as a basis for accepting. If not accepted or if nothing was found, state evidence used as basis for establishing location. If reestablished through lost corner proportionate methods, indicate all monuments, distances and directions used to establish.

Original Alex Anderson Sept 1863. OBT's Lind 10" S 39¹/₂°E 26 lks, Lind 9" N 57¹/₂°W 18 lks
 Dorr in 11/3/1898 did not find cor., but set it, BT Sugar 16" N 14°W 45 lks.
 I found on 5/20/82 a 3/4" i.p. & BT's OR 14" N 8°W 18.0' (to ctr), OR 11" S 69°E 36.7'.
 Distance to south checks good.
 Made three more BT's in Apr. 1984.

(c) (d) (e) Plan view of corner with ties to at least 4 witness monuments. If in disagreement with previously established corner, show the distances between the two corners and also indicate the ties to the disputed corner.

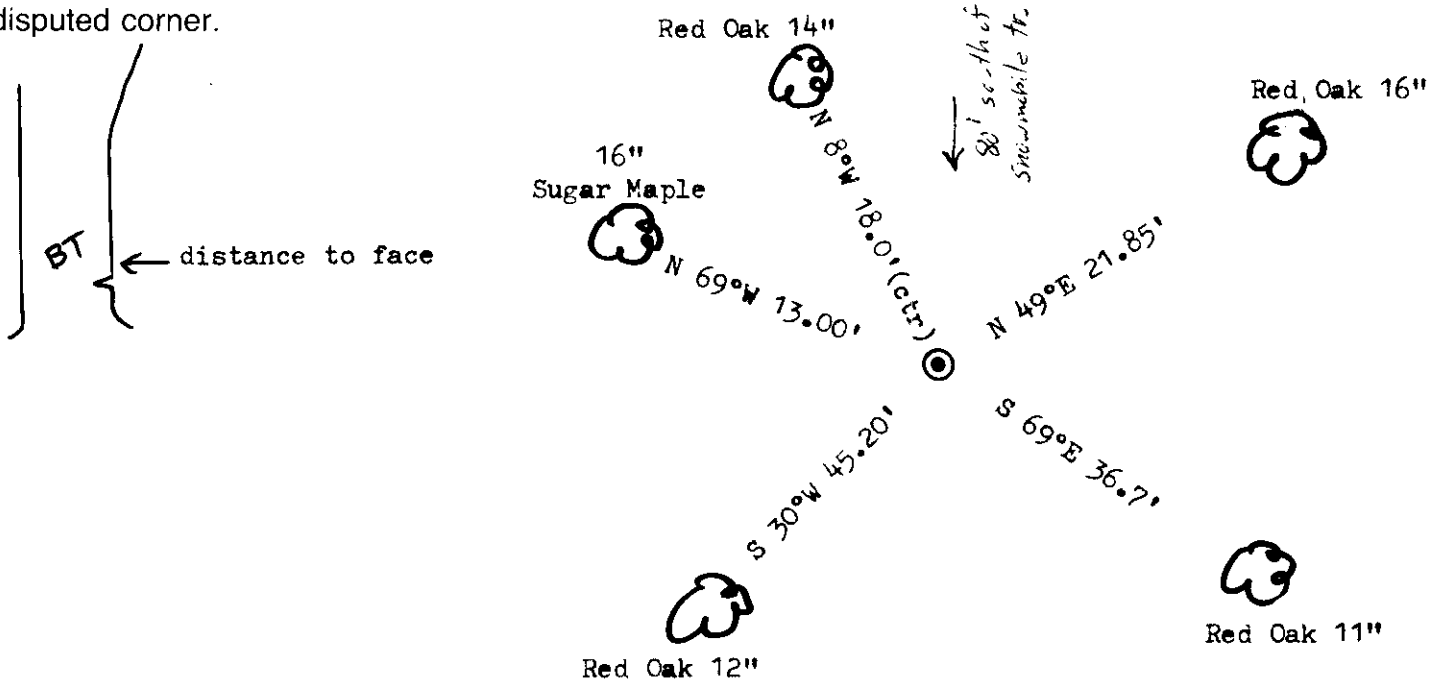

(i) I, Marvin E. Seymour
 (type or print name) certify that the corner location on this record was determined by me or under my direction and control and that this U.S. Public Land Survey Monument Record is correct and complete to the best of my knowledge and belief.



Marvin E. Seymour April 25, 1984
 Signature Date

3907202000

p-9