


U.S. PUBLIC LAND SURVEY MONUMENT RECORD

Note: This form is intended and designed to fulfill all requirements of Wisconsin Administrative Code, Chapter A-E 5.02, U.S. Public Land Survey Monument Record (3) (a) (b) (c) (d) (e) (f) (g) (h) (i). An additional sheet may be added if necessary to conform with said requirements.

(a) Corner location: Township 39 North
 Range 7 East ~~11~~

Town ~~Oneida~~ of Woodruff

County Oneida

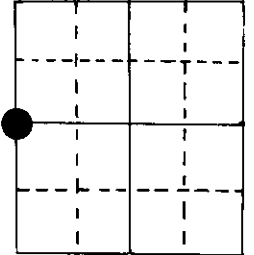

W¹/₄ Section 23

4" Wood Post

(b) (f) (g) (h) Description of monument found at this corner and if it was accepted, state all evidence (material, testimonial, occupational, plats, records, other monuments) used as a basis for accepting. If not accepted or if nothing was found, state evidence used as basis for establishing location. If reestablished through lost corner proportionate methods, indicate all monuments, distances and directions used to establish.

Original Alex Anderson Sept 1863. OBT's Tam 8" S 30°W 8 lks, Tam 10" N 82°E 4 lks

Wood post is in water now because of water level being so much higher. (1983)

Dorr was at this cor. on 1/ 21/ 1898. Did not say anything about it.


Vaughn on 8/24/13 found ¹/₄ post and made new BT Maple 12" S 83°E 31 lks as orig. BT's were almost gone.

I found on 6/8/83 the wood post in water and BT's stp 20" S 58°W 16.50',
 FB 12" N 62°W 80.15'

Made two more BT's.

Distances to here from E¹/₄ & C¹/₄ check with Vaughn's work.

(c) (d) (e) Plan view of corner with ties to at least 4 witness monuments. If in disagreement with previously established corner, show the distances between the two corners and also indicate the ties to the disputed corner.

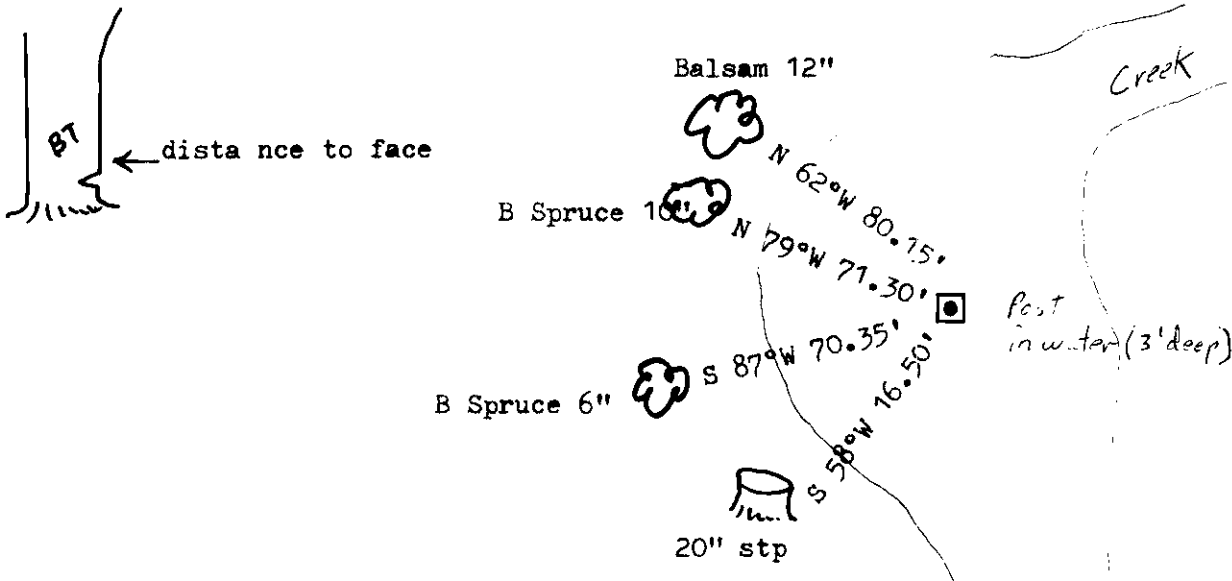

(i) I, Marvin E. Seymour
 (type or print name) certify that the corner location on this record was determined by me or under my direction and control and that this U.S. Public Land Survey Monument Record is correct and complete to the best of my knowledge and belief.

Marvin E. Seymour April 20, 1984
 Signature Date



P-17

3907222000