

# U.S. PUBLIC LAND SURVEY MONUMENT RECORD


Note: This form is intended and designed to fulfill all requirements of Wisconsin Administrative Code, Chapter A-E 5.02, U.S. Public Land Survey Monument Record (3) (a) (b) (c) (d) (e) (f) (g) (h) (i). An additional sheet may be added if necessary to conform with said requirements.

(a) Corner location: Township 39 North  
 Range 7 East ~~East~~

Town ~~City~~ Edge of Woodruff

County Oneida

4"x4" concrete

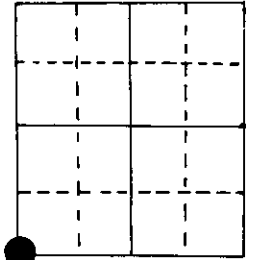

SW Section 35

(b) (f) (g) (h) Description of monument found at this corner and if it was accepted, state all evidence (material, testimonial, occupational, plats, records, other monuments) used as a basis for accepting. If not accepted or if nothing was found, state evidence used as basis for establishing location. If reestablished through lost corner proportionate methods, indicate all monuments, distances and directions used to establish.

Original Alex Anderson Sept 1860. OBT's PW 30" N 42°E 26 lks, PW 12" N 47°W 102 lks  
 PW 12" S 26°E 139 lks

Dorr in 11/27/1893 found cor. & orig Pine 30" N 43°E 0.265 ch


Hall set 6"x6" conc. at 6" exposed by using record orig. distances from 3 OBT's.  
 New BT's PY 9" S 26°E 1.532 ch, PY 14" N 60°E 1.293 ch

Ilg, 1965, set conc post with brass cap, Hall's BT's are OK. New BT's MR 6" n 30°E 0.724 ch  
 OR 9" N 39°W 0.304 ch

F. Copp in 10/18/79 found conc post and all BT's OK

Seymour on 5/82 found conc post & BT's OK.

(c) (d) (e) Plan view of corner with ties to at least 4 witness monuments. If in disagreement with previously established corner, show the distances between the two corners and also indicate the ties to the disputed corner.

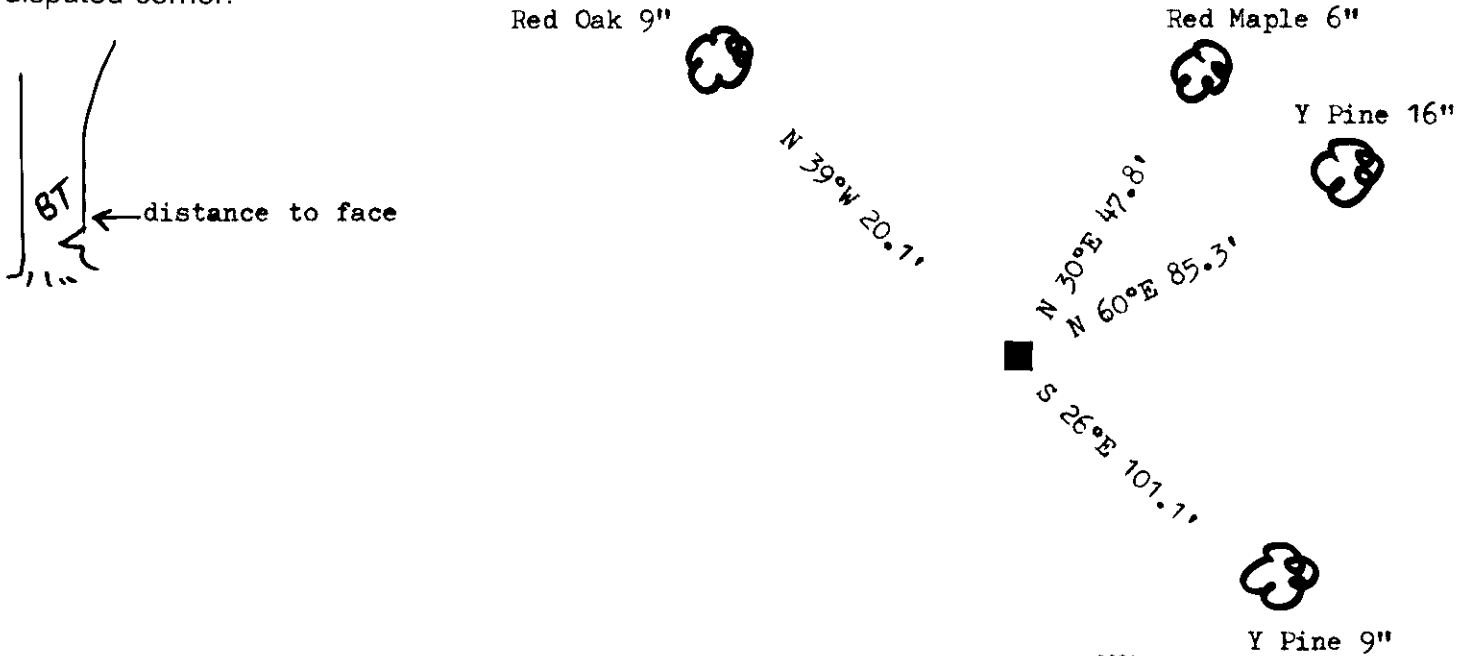

(i) I, Marvin E. Seymour  
 (type or print name) certify that the corner location on this record was determined by me or under my direction and control and that this U.S. Public Land Survey Monument Record is correct and complete to the best of my knowledge and belief.

Marvin E. Seymour April 30, 1984  
 Signature Date



2-17

3907340000