

U.S. PUBLIC LAND SURVEY MONUMENT RECORD


Note: This form is intended and designed to fulfill all requirements of Wisconsin Administrative Code, Chapter A-E 5.02, U.S. Public Land Survey Monument Record (3) (a) (b) (c) (d) (e) (f) (g) (h) (i). An additional sheet may be added if necessary to conform with said requirements.

(a) Corner location: Township 39 North
 Range 7 East ~~Forest~~

Town ~~Oneida~~ of Woodruff

County Oneida

2" iron pipe with brass cap

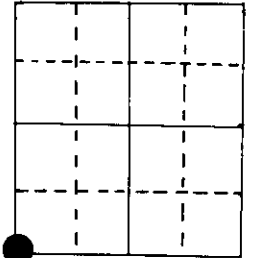

SW cor Section 36

(b) (f) (g) (h) Description of monument found at this corner and if it was accepted, state all evidence (material, testimonial, occupational, plats, records, other monuments) used as a basis for accepting. If not accepted or if nothing was found, state evidence used as basis for establishing location. If reestablished through lost corner proportionate methods, indicate all monuments, distances and directions used to establish.


Original Alex Anderson Sept 1860. OBT's B Oak 14" N 52°W 27 lks, Asp 16" S 77°W 25 lks
 BW 5" N 52°E 29 lks, PW 40" S 78°E 50 lks

Berndt & Mentz, Aug 1961, at 40.140 west of S $\frac{1}{4}$ found SW cor. broken off & dug and recovered point of post. Set 2" brass cap, BT's twin Oak 9" S 53°W 0.240 ch
 twin Oak 10" N 24°E 0.460 ch
 Oak 7" N 34°W 0.580 ch

Ilg, 1965, found cor. , Oak 7" now 10", new BT MH 6" N 37°E 0.283 ch.

I found on 11/6/80 brass cap & BT's OK.

(c) (d) (e) Plan view of corner with ties to at least 4 witness monuments. If in disagreement with previously established corner, show the distances between the two corners and also indicate the ties to the disputed corner.

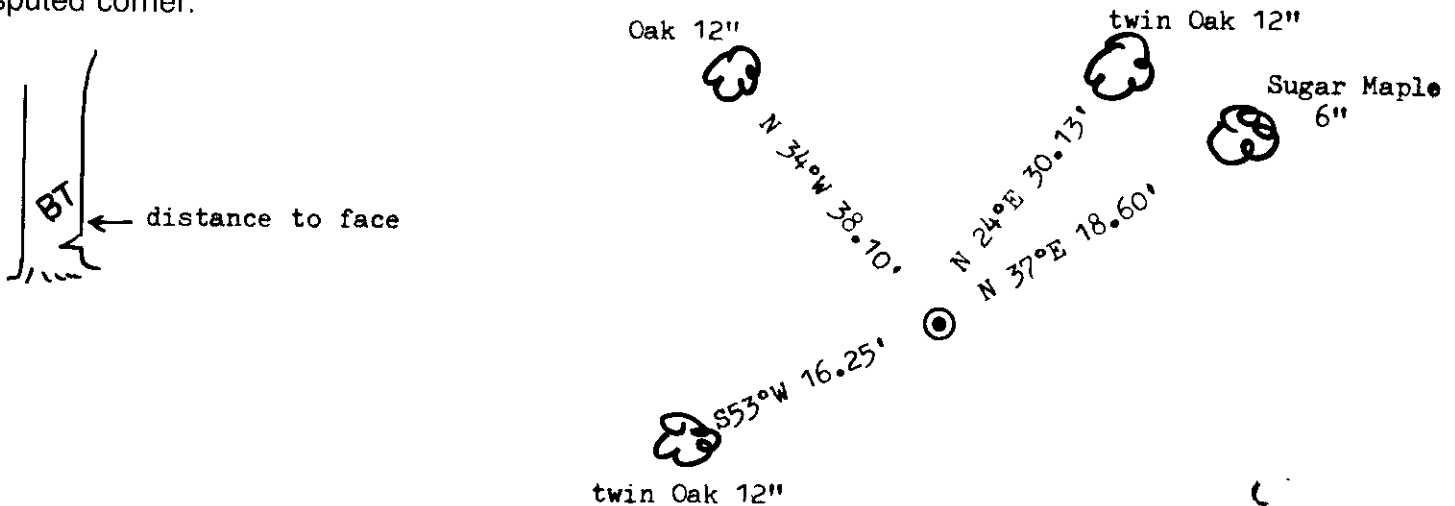

(i) I, Marvin E. Seymour
 (type or print name) certify that the corner location on this record was determined by me or under my direction and control and that this U.S. Public Land Survey Monument Record is correct and complete to the best of my knowledge and belief.

Marvin E. Seymour April 30, 1984
 Signature Date



2-21

3907350000