

U.S. PUBLIC LAND SURVEY MONUMENT RECORD

Note: This form is intended and designed to fulfill all requirements of Wisconsin Administrative Code, Chapter A-E 7.08 U.S. Public Land Survey Monument Record (3) (a) (b) (c) (d) (e) (f) (g) (h) (i). An additional sheet may be added if necessary to conform with said requirements.


(a) Corner location: Township 39 North Corner: North 1/4 Corner

Section 17 Range 8 East Original Surveyor: A. Anderson

Town/City/Village Newbold

Original B.T.'s: 16" Pj S66°W 12 lks
15" Fw N46°E 37 lks

County Oneida

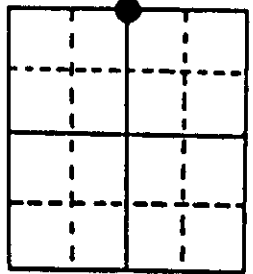

Original Survey Date: July 1863 ● Location


(b) (f) (g) (h) Description of monument found at this corner and if it was accepted, state all evidence (material, testimonial, occupational, plats, records, other monuments) used as a basis for accepting. If not accepted or if nothing was found, state evidence used as basis for establishing location. If reestablished through lost corner proportionate methods, indicate all monuments, distances and directions used to establish. Indicate type of monument found or set and sign post.

Found and accepted an old uncapped 2" dia. iron pipe monument 22" above grade at this corner location. I carefully removed the 48" long iron pipe monument and reset the corner location with a standard 2" dia. x 48" long iron pipe monument with a stamped brass cap 18" above grade, and left the older iron pipe monument flat on grade along side of the new one. All original GLO survey corner evidence is now obliterated and/or uncertain due to decay and other factors.

In 1938, Wisconsin Valley Improvement Company noted the older 2" dia. iron pipe at this corner was set at 39.258 chains each way on a right line between section corners, and RTs, a 7" Oak N54°W 0.889 ch now gone or uncertain, and a 6" Oak S67°E 0.506 ch found as a 23" Oak S65°E with no visible markings but with a standard WCD aluminum section locator plate nailed to face about 6' above grade.

I set a standard white poly 'T' corner marker post 1' North of the corner monument and I brushed/flagged a line North 90'+/- to centerline of an east/west dirt roadway named Rainbow Drive. This recovery completed 8-11-97; no witnesses.

(c) (d) (e) Plan view of corner with ties to at least 4 witness monuments. If in disagreement with previously established corner, show the distances between the two corners and also indicate the ties to the disputed corner.

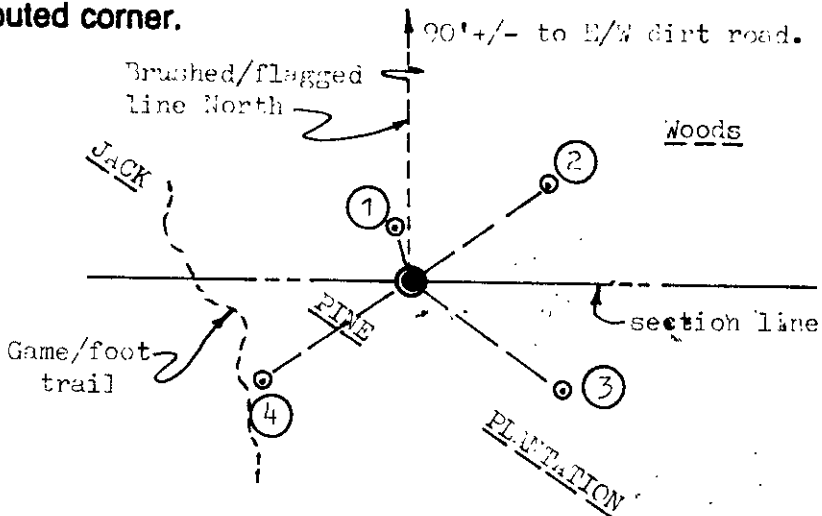


Witness Monument Ties:

- ① New BT 6" Pj N15°W 5.95'.
- ② New BT 8" Pj N55°E 17.42'.
- ③ New BT S54°E 19.60', 8" Pr.
- ④ New BT 9" Pj S56°W 18.49'.

Unless otherwise indicated, all BT witness monument ties are to a 1/4" dia. by 2.5" long PK nail with 1.25" dia. steel washer set in unblazed right face bark; and a PK nail with 2" dia. steel washer stamped BT also set in unblazed front face bark of each BT at DBH. All previous corner recovery notes from Wisconsin DNR and/or Oneida County survey records.



Scale: 1" = 20'

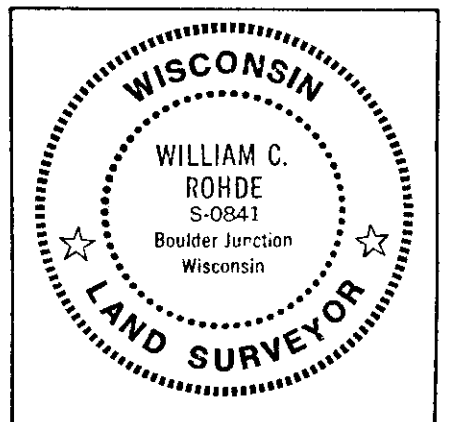

(i) I, William C. Rohde, RLS 841
(type or print name) certify that the corner location on this record was determined by me or under my direction and control and that this U.S. Public Land Survey Monument Record is correct and complete to the best of my knowledge and belief.


William C. Rohde
Signature

August 24, 1997
Date

U.S. PUBLIC LAND SURVEY MONUMENT RECORD

Note: This form is intended and designed to fulfill all requirements of Wisconsin Administrative Code, Chapter A-E 7.08 U.S. Public Land Survey Monument Record (3) (a) (b) (c) (d) (e) (f) (g) (h) (i). An additional sheet may be added if necessary to conform with said requirements.

(a) CORNER LOCATION: WISCRS (Oneida County)
1/4 Cor. of Secs. 8 & 17 N: 251,420.29 USft
Township 39 North E: 236,699.73 USft
Range 8 East of the 4th P.M. Datum: NAD 1983(2011)
Town of Newbold County of Oneida

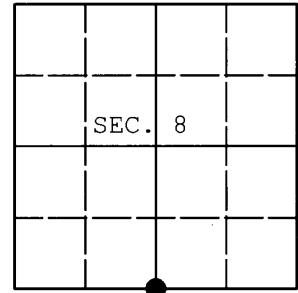

(b) HISTORY OF ORIGINAL CORNER ESTABLISHMENT

Original Surveyor: Original Accessories:
Date of Survey: Commenced:
Completed:

(b) (f) (g) (h) Description of monument found at this corner and if it was accepted, state all evidence (material, testimonial, occupational, plats, records, other monuments) used as a basis for accepting. If not accepted or if nothing was found, state evidence used as basis for establishing location. If re-established through lost corner proportionate methods, indicate all monuments, distances and directions used to establish. Indicate type of monument and sign post found or set.

NOTE: This is a perpetuation of a previous USPLS Monument Record by William C. Rohde, RLS dated August 24, 1997 and filed in the office of the Oneida County Register of Deeds. A complete history of the corner can be found on the previous monument record. I accept the previous location as a true and faithful perpetuation or reestablishment of the original corner location and further perpetuate it as follows.

March 19, 2014: I found and accepted Rohde's monument, a 2.5" diam. iron pipe with brass cap. Rohde's accessories were found in substantial agreement with his previous record and were not remeasured as the sole purpose of this work is to report the coordinates of the corner point.

The coordinates shown were derived from a direct RTN GPS observation referenced to the WISCORS network.

(c) (d) (e) Plan view of corner with ties to at least 4 witness monuments. If in disagreement with previously established corner, show the distances between the two corners and also indicate the ties to the disputed.

REGISTER OF DEEDS OFFICE
ONEIDA COUNTY
FILED

MAY 22 2014

AT _____ O'CLOCK _____ M
KYLE J. FRANSON
REGISTER OF DEEDS

(i) I, Jeffrey W. Austin, Registered Land Surveyor No. S-1885, hereby certify that the corner location on this record was determined by me or under my direction and control and that this U.S. Public Land Survey Monument Record is correct and complete to the best of my knowledge and belief.



Signature

Date

MAY 9 2014

3908080020 (INDEX NO. J-7)