

U.S. PUBLIC LAND SURVEY MONUMENT RECORD

Note: This form is intended and designed to fulfill all requirements of Wisconsin Administrative Code, Chapter A-E 7.08 U.S. Public Land Survey Monument Record (3) (a) (b) (c) (d) (e) (f) (g) (h) (i). An additional sheet may be added if necessary to conform with said requirements.


(a) Corner location: Township 39 North Corner: North 1/4 Corner

Section 15 Range 8 East Original Surveyor: A. Anderson

Town/City/Village Newbold

Original B.T.'s: 10' Py ?? 17 lks
10' Py ?? 16 lks

County Oneida

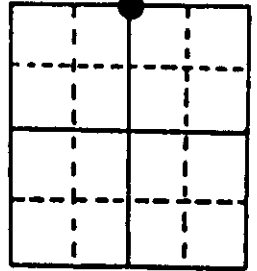


Original Survey Date: July 1863 ● Location

(b) (f) (g) (h) Description of monument found at this corner and if it was accepted, state all evidence (material, testimonial, occupational, plats, records, other monuments) used as a basis for accepting. If not accepted or if nothing was found, state evidence used as basis for establishing location. If reestablished through lost corner proportionate methods, indicate all monuments, distances and directions used to establish. Indicate type of monument found or set and sign post.

Found and accepted a rusted uncapped 2" dia. iron pipe monument with top tipped 15° and 23" above existing grade at corner location. I carefully removed the 48" long iron pipe with a coupling on bottom end and reset corner with a standard 2" dia. by 48" long iron pipe with stamped DNR brass cap 22" above grade. I left old iron pipe monument flat on grade along NW side of new monument. No original GLO survey corner evidence recovered or existing at this location. In 1938, the Wisconsin Valley Improvement Company set a 2" dia. iron pipe at this corner upon the basis of a section line resurvey; their 14" Pn BT N19°W 0.035 chains is now a 20" Pn I used for new ties below, and their 8" Pn BT S79°E 0.208 chains is now an 8" dead 4 foot high stub at S77°E. Face blazes and scribing are plain on both BTs. This recovery completed July 28, 1997; no witnesses.

(c) (d) (e) Plan view of corner with ties to at least 4 witness monuments. If in disagreement with previously established corner, show the distances between the two corners and also indicate the ties to the disputed corner.

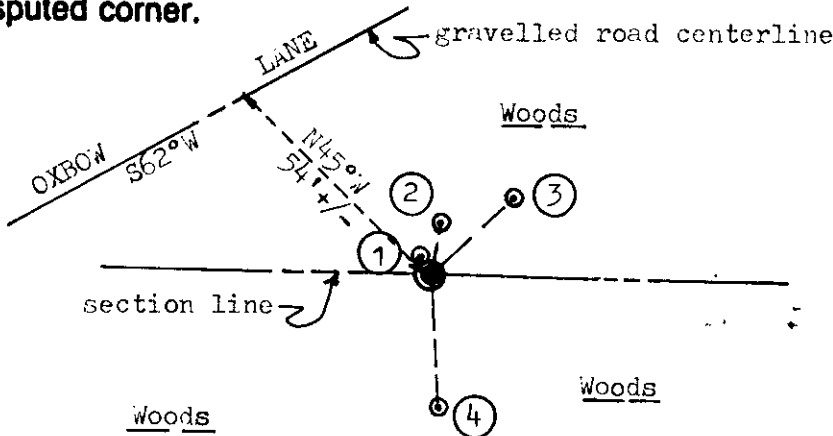

Witness Monument Ties:

- ① Record BT 20" Pn N21°W 2.87'.
- ② New BT 16" Pw N08°E 11.87'.
- ③ New BT 18" Pn N46°E 24.29'.
- ④ New BT 6" Aspen S02°E 28.26'.


Standard white poly 'T' corner marker post set 12" South of corner monument.

Unless otherwise indicated, all BT witness monument ties are to a 1/4" dia. by 2.5" long PK nail with 1.25" dia. steel washer set in unblazed right face bark; and a PK nail with 2" dia. steel washer stamped BT also set in unblazed front face bark of each BT at DBH. All previous corner recovery notes from Wisconsin DNR and/or Oneida County survey records.

(i) I, William C. Rohde, RLS 841
(type or print name) certify that the corner location on this record was determined by me or under my direction and control and that this U.S. Public Land Survey Monument Record is correct and complete to the best of my knowledge and belief.



Scale: 1" = 40'

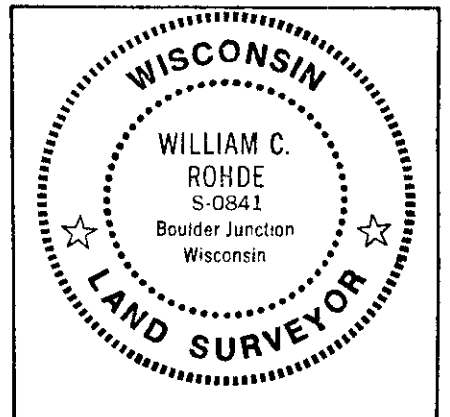

Index No. 715

William C. Rohde
Signature

July 29, 1997
Date