U.S. PUBLIC LAND SURVEY MONUMENT RECORD

Note: This form is intended and designed to fulfill all requirements of the Wisconsin Administrative Code, Chapter A-E 7.08 U.S. Public Land Monument Record (3)(a)(b)(c)(d)(e)(f)(g)(h)(i). An additional sheet may be added if necessary to confrom with said requirements.

(a) CORNER LOCATION:

Meander Corner east line Sect. 10
Township 39 North
Range 8 East
Town of Newbold
County of Oneida

COORDINATES

North:
East:
Control Station:
Latitude:
Longitude:
Datum Method

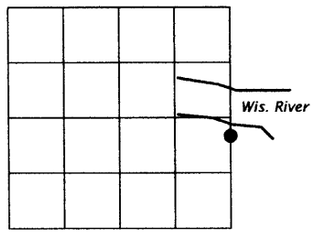

SECTION 10

(b) HISTORY OF ORIGINAL CORNER ESTABLISHMENT

Original Surveyor:
Date of Survey: Commenced
Completed

Original B.T.'S

(f)(g)(h) DESCRIPTION OF MONUMENT FOUND AT THIS CORNER AND IF IT WAS ACCEPTED, STATE ALL EVIDENCE (MATERIAL, TESTIMONIAL, OCCUPATIONS, PLATS, RECORDS, OTHER MONUMENTS) USED AS A BASISFOR ESTABLISHING LOCATION. IF NOT ACCEPTED OF IF NOTHING WAS FOUND, STATE EVIDENCE USED AS BASIS FOR ESTABLISHING LOCATION. IF REESTABLISHED THROUGH LOST CORNER PROPORTIONATE METHODS, INDICATE ALL MONUMENTS, DISTANCES AND DIRECTIONS USED TO ESTABLISH. INDICATE TYPE OF MONUMENT AND SIGN POST FOUND OR SET.

Note: The original Quarter Corner and Meander Corner are now in the Wisconsin River, due to the raised water elevation caused by the Rainbow Flowage. This corner form is a perpetuation of the Meander Corner set by the Wisconsin Valley Improvement Corporation.

Wisconsin Valley Improvement Corporation: Oneida County Survey Map No. B2553, sets a Meander Corner on a straight line between the Northeast Section Corner and the Southeast Section Corner, near the southerly bank of the Wisconsin River. The Meander Corner is 2,538.1 feet north of the Southeast Section Corner (WVIC survey data), and was witnessed by the following bearing trees: 15" N. Pine N69W 23.0' distant and a 10" N. Pine N 11-40'E 15.6' distant.

Wisconsin Valley Improvement Corporation: On corner data sheet dated May 14, 1981, identifies the Meander Corner to be monumented with a 2 3/8" dia. iron pipe, and witnessed by the following bearing trees: 22" R. Pine N64W 22.7' distant and a 18" R. Pine N15E 15.2' distant.

Michael L. Oestreich: 1/13/05, recovered a 2.4" dia. iron pipe, and the following witnesses: an 18" Red Pine, blaze grown shut N14E 15.92 distant and a 23" dia. Red Pine, blaze grown shut N68W 23.49' distant. I replaced the iron pipe with a capped aluminum monument, stamped to identify corner, and made ties as shown in the plan below.

(c)(d)(e) PLAN VIEW OF CORNER WITH TIES TO AT LEAST 4 WITNESS MONUMENTS. IF IN DISAGREEMENT WITH PREVIOUSLY ESTABLISHED CORNER, SHOW THE DISTANCE BETWEEN THE TWO CORNERS AND ALSO

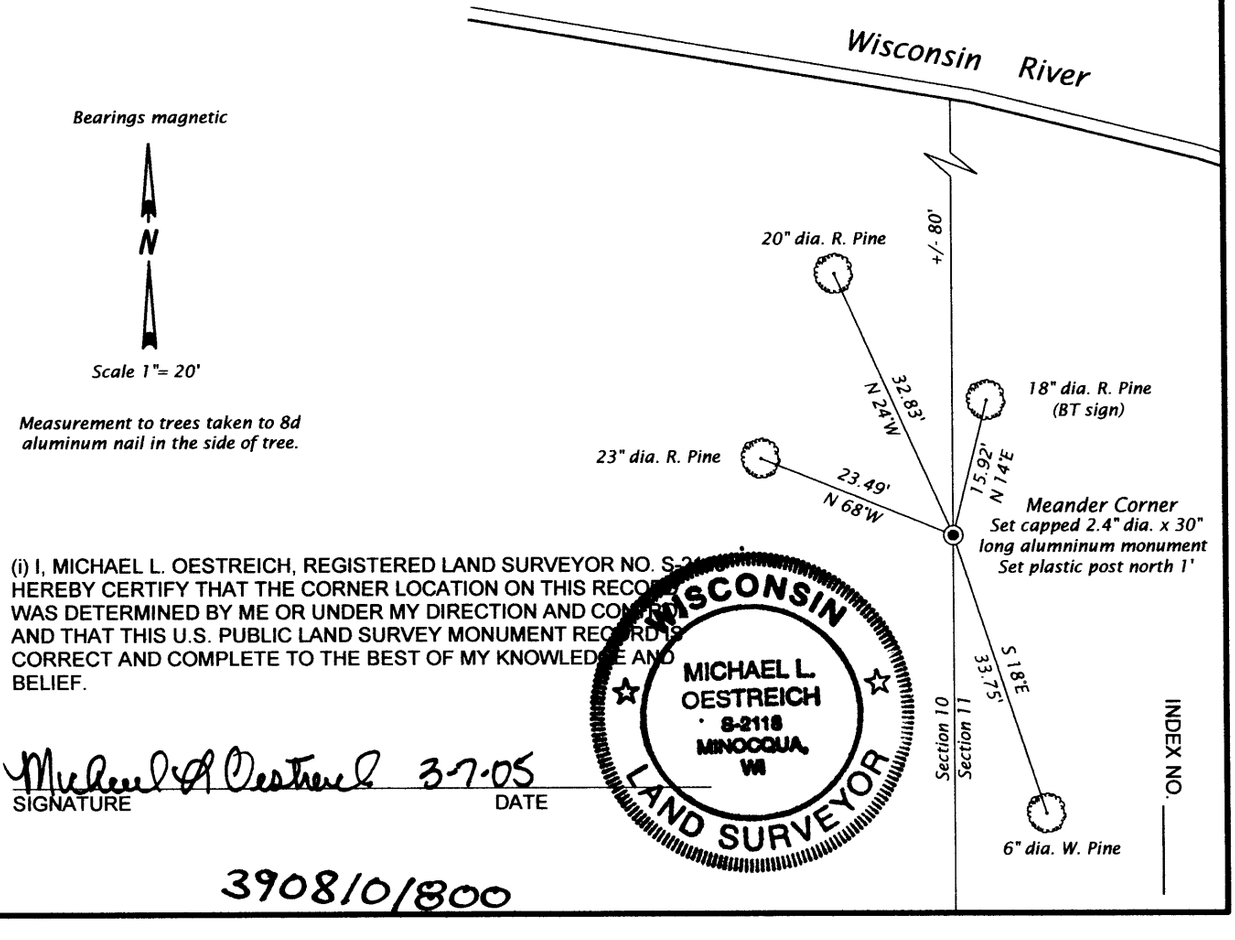

(i) I, MICHAEL L. OESTREICH, REGISTERED LAND SURVEYOR NO. S-2[illegible] HEREBY CERTIFY THAT THE CORNER LOCATION ON THIS RECO[illegible] WAS DETERMINED BY ME OR UNDER MY DIRECTION AND CO[illegible] AND THAT THIS U.S. PUBLIC LAND SURVEY MONUMENT RECORD IS CORRECT AND COMPLETE TO THE BEST OF MY KNOWLEDGE AND BELIEF.

WISCONSIN
MICHAEL L. OESTREICH
S-2116
MINOCQUA, WI
LAND SURVEYOR

Michael L Oestreich 3-7-05
SIGNATURE DATE

3908101800

U.S. PUBLIC LAND SURVEY MONUMENT RECORD

Note: This form is intended and designed to fulfill all requirements of Wisconsin Administrative Code, Chapter A-E 7.08 U.S. Public Land Survey Monument Record (3)(a-i).

(a) CORNER LOCATION
Meander Cor. of Secs. 10 & 11
Township 39 North
Range 8 East of the 4th P.M.
Town of Newbold
County of Oneida

WISCRS - Oneida County
N: 253,923.20 USft
E: 249,740.30 USft
Datum: NAD 83(2011)
GNSS Method: RTN - Direct
GNSS Control: WISCORS VRS

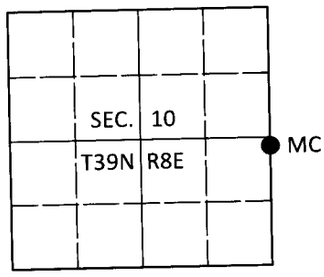

(b) HISTORY OF ORIGINAL CORNER ESTABLISHMENT

Original Surveyor:

Original Accessories:

Date of Survey Commenced:
Completed:

See previous monument record(s)

(b)(f)(g)(h) Description of monument found at this corner and if it was accepted, state all evidence (material, testimonial, occupational, plats, records, other monuments) used as a basis for accepting. If not accepted or if nothing was found, state evidence used as basis for establishing location. If re-established through lost corner proportionate methods, indicate all monuments, distances and directions used to establish. Indicate type of monument and sign post found or set.

This is a perpetuation of the following monument record(s) that comprise a complete history of the corner:

Mar. 7, 2005: USPLS Monument Record No. 3908101800 by Michael L. Oestreich, PLS

Oct. 16, 2019: I found and accepted the record monument, a 2.4" diam. aluminum pipe with a 3.3" diam. Oneida Co. aluminum cap projecting 2" above the ground surface. I found or established accessories as shown below. I found a white vinyl sign post bearing North, 1.0 ft.

The coordinate value shown has been verified by at least one of the following methods: 1) comparison to a previously GPS determined published value; 2) the value is the average of two or more GPS observations at a markedly different time; 3) one or more distances were measured back to the GPS observed corner from temporary GPS observed offset locations.

(c)(d)(e) Plan view of corner with ties to at least 4 witness monuments. If in disagreement with previously established corner, show the distances between the two corners and also indicate the ties to the disputed.

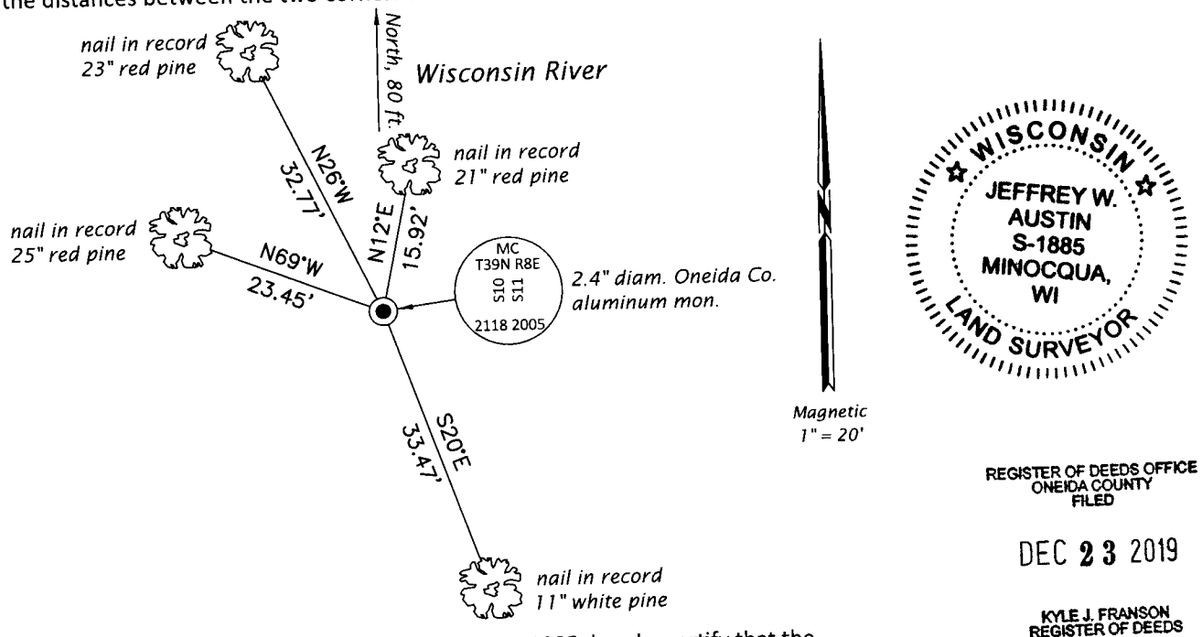

WISCONSIN
JEFFREY W. AUSTIN
S-1885
MINOCQUA, WI
LAND SURVEYOR

REGISTER OF DEEDS OFFICE
ONEIDA COUNTY
FILED

DEC 23 2019

KYLE J. FRANSON
REGISTER OF DEEDS

(i) I, Jeffrey W. Austin, Professional Land Surveyor No. S-1885, hereby certify that the corner location on this record was determined by me or under my direction and control and that this U.S. Public Land Survey Monument Record is correct and complete to the best of my knowledge and belief.

Signature

5 DEC 2019
Date

3908101800 (INDEX NO. G,H-17)