



CERTIFIED LAND CORNER RESTORATION

Index No. J-23

State of Wisconsin } ss.
 County of Oneida

I Daniel K. Plegger, do hereby certify that on the 15th day of July, 1980, I found evidence of the Quarter corner of Sections 12 and 13 Township 39, North, Range 8 East, Fourth Principal Meridian, as described hereon; and that from this evidence I established a new monument and accessories as described hereon to perpetuate the original location of this corner.

Resident witnesses:

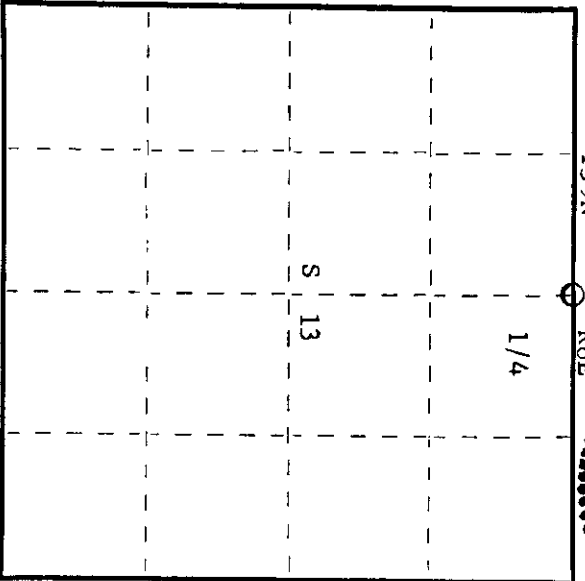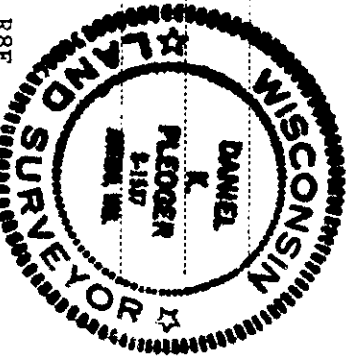

○ = Corner monument restored.

History of original corner establishment:

Corner established by Alexander Anderson, deputy surveyor, in 1863, from which black pine 10" bears N 75° W, 117 links and black pine 9" bears S 74-1/2° W, 117 links.

Description of corner evidence found:

Recovered a 2" iron pipe driven along side an old rotted cedar post.
 ORT -
 R. Pine stump 10" N83° W 57.9 feet
 scribing partially legible.

Description of monument and accessories I established to perpetuate the original location of this corner.
 Replaced old post with a 2-1/2" Oneida County federal monument A-1 with alloy cap - stamped:
 Monument projects 24" above ground.

Marked NBT's -
 Jack Pine 5" S26°E 98.35 feet T39N R8E
 Jack Pine 6" S4°E 66.78 feet 1/4 S 12
 Jack Pine 5" S83°W 61.80 feet S 13
 S1537-1980

Dated at Rhineland, Wis., this 8th day of October, 1980

Signature Daniel K. Plegger Title Registered Land Surveyor Registration No. 1537
 (County Surveyor, Registered Land Surveyor, or other duly authorized official)

Office of Register of Deeds, County of Oneida, I hereby certify that the within instrument was filed in this office for record on the 20th day of October, 1980 at 1:00 o'clock P. M.

Doris George Trush
 (Register of Deeds)

By: _____ Deputy

3908120020