

CERTIFIED LAND CORNER RESTORATION

Index No. K - 23



State of Wisconsin

County of Oneida } ss.

History of original corner establishment:
No record of any previous survey.

I Daniel K. Pleoeger, do hereby certify that on the 18th day of July, 1980, I found ~~marked~~ marked the NC 1/16 corner of Section 13 Township 39, North, Range 8 East, Fourth Principal Meridian, as described hereon; and that from this evidence I established a new monument and accessories as described hereon to perpetuate the original location of this corner.

Resident witnesses:

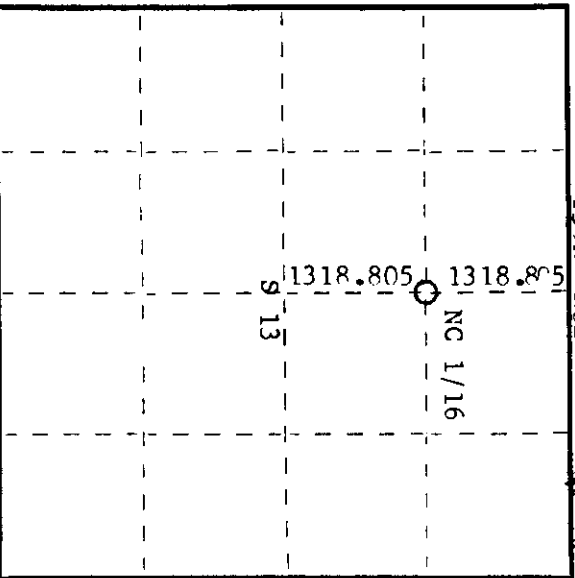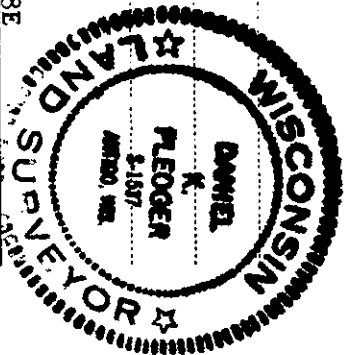

○ = Corner monument restored.

Description of corner evidence found:

Corner established by proportional measurement.
Computed line between 1/4 corner between sections 12 and 13 to C 1/4 corner. Section 13 is S 1° 42' W, 2637.611 feet.
Set NC 1/16 1318.805 feet intermediate.

Description of monument and accessories I established to perpetuate the original location of this corner.

Set a 1-1/2" iron pipe with 2" brass cap, stamped:
Monument projects 18" above ground.
Marked NBT's:
Red Pine 14" S6°W 20.15 feet T39N R8E
Maple 9" S82°W 18.45 feet NC 1/16 S 13
S-1537 - 1980

Dated at Rhineland, Wis., this 8th day of October, 1980.

Signature Daniel K. Pleoeger Title Registered Land Surveyor Registration No. 1537
(County Surveyor, Registered Land Surveyor, or other duly authorized official)

Office of Register of Deeds, County of Oneida I hereby certify that the within instrument was filed in this office for record on the 30th day of October, 1980 at 1:00 o'clock P. M.

Terrie Verage Kuehn
(Register of Deeds)

By _____ Deputy

3908133020