

CERTIFIED LAND CORNER RESTORATION

Index No. K-22

State of Wisconsin

County of Oneida } ss.

I Daniel K. Pleogger, do hereby certify that on the 17th day of July, 19 80, I found established ~~marked~~ the NW 1/16 corner of Section 13

Township 39, North, Range 8 East, Fourth Principal Meridian, as described hereon; and that from this evidence I established a new monument and accessories as described hereon to perpetuate the original location of this corner.

Resident witnesses:

Glen Barker

Jim Clafflin

History of original corner establishment:

Established corner at intersection of N-S and E-W 1/16 lines of the NW 1/4 of section 13.

Description of corner evidence found:



No records or evidence of any previous surveys.

Description of monument and accessories I established to perpetuate the original location of this corner.

Set a 1-1/2" O.D. iron pipe with 2" brass cap, projecting 18", stamped:

Marked NBT's:  
W.Pine 5" S28°W 71.41 feet  
J.Pine 6" S22°E 107.62 feet  
both scribed 1/16 BT.

T39N R8E  
NW 1/16 S 13  
S1537  
CPI-1980

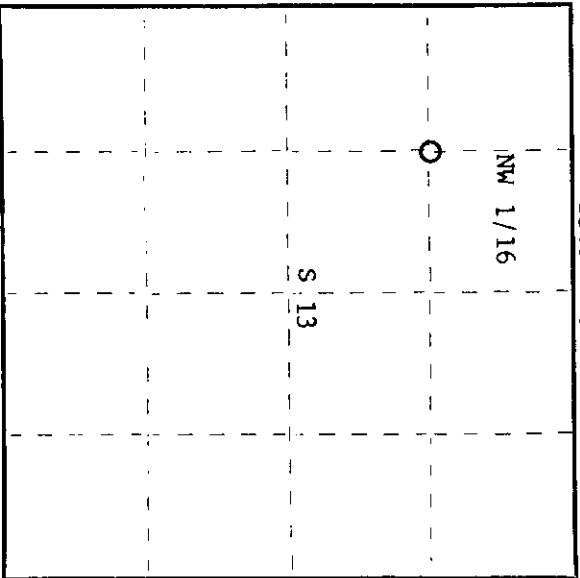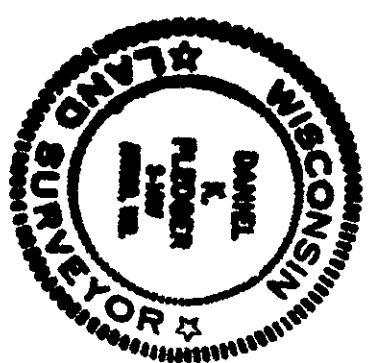

○ = Corner monument restored.

Dated at Rhineland, Wis., this 7th day of August, 19 80.

Signature Daniel K. Pleogger Title Registered Land Surveyor Registration No. 1537  
(County Surveyor, Registered Land Surveyor, or other duly authorized official)

Office of Register of Deeds, County of Oneida  
at 100 o'clock P M. 20th day of October, 19 80

Doris George Finkbe  
(Register of Deeds)

By: \_\_\_\_\_ Deputy

3908133030