U.S. PUBLIC LAND SURVEY MONUMENT RECORD

NOTE: THIS FORM IS INTENDED AND DESIGNED TO FULFILL ALL REQUIREMENTS OF WISCONSIN ADMINISTRATIVE CODE CHAPTER A-E 7.08 U.S. PUBLIC LAND SURVEY MONUMENT RECORD (3) (a)(b)(c)(d)(e)(f)(g)(h)(i). AN ADDITIONAL SHEET MAY BE ADDED IF NECESSARY TO CONFIRM WITH SAID REQUIREMENTS.

(a) CORNER LOCATION:

S 1/4 CORNER OF SECTION 19
TOWNSHIP 39 NORTH
RANGE 8 EAST
TOWN OF NEWBOLD
COUNTY OF ONEIDA

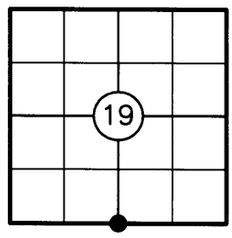

(b) HISTORY OF ORIGINAL CORNER:

ORIGINAL SURVEYOR: ALEXANDER ANDERSON
DATE OF SURVEY: COMMENCED JULY, 1863
COMPLETED JULY, 1863

ORIGINAL BEARING TREES: 24" W. PINE - N70°W, 28 LKS.
24" W. PINE - S66°W, 22 LKS.

(f)(g)(h) DESCRIPTION OF MONUMENT FOUND AT THIS CORNER AND IF IT WAS ACCEPTED STATE ALL EVIDENCE (MATERIAL, TESTIMONIAL, OCCUPATIONAL, PLATS, RECORDS, OTHER MONUMENTS) USED AS A BASIS FOR ESTABLISHING LOCATION. IF REESTABLISHING THROUGH LOST CORNER PROPORTIONATE METHODS, INDICATE ALL MONUMENTS, DISTANCES, AND DIRECTIONS USED TO ESTABLISH. INDICATE TYPE OF MONUMENT AND SIGN POST FOUND OR SET.

4/24/1946: A.J. LYTLE MAKES NOTE OF THE CORNER IN HIS SURVEY NOTES.

1/12/1954: F.R. WINCENTSEN, COUNTY SURVEYOR, FOUND AN IRON PIPE AND ORIGINAL BT STUMP AS INDICATED IN HIS FIELD NOTES AND ON GENISOT ENGINEERING CO. DWG. NO. 1401-1. HE NOTES AN ERRONEOUS SECTION LINE TO THE SOUTH.

1/13/1958: JOSEPH C. KIRBY, LAND SURVEYOR FOR GENISOT ENGINEERING CO., SHOWS S1/4C ON DWG. NO. 2122.

4/22/1958: JOSEPH C. KIRBY, LAND SURVEYOR FOR GENISOT ENGINEERING CO., SHOWS CORNER ON DWG. NO. 2122-2.

5/6/2005: I FOUND A 1" O.D. X 38" IRON PIPE 4" BELOW THE ROAD SURFACE AND 2 FEET WEST OF CENTERLINE OF RAINBOW LAKE ROAD. I REMOVED THE PIPE FOR THE PURPOSE OF EXAMINATION AND MEASURING THE LENGTH AND REPLACED WITH A 1" O.D. X 18" IRON PIPE BELOW THE ROAD SURFACE. I FOUND REMAINS OF AN OLD PINE BT STUMP S66°W, 14.5 FEET. THE DISTANCE CHECKS FAVORABLY TO THE BT STUMP REMAINS AND THE TOPO CALL ENTERING THE WILLOW BOTTOM.

(c)(d)(e) PLAN VIEW OF CORNER WITH TIES TO AT LEAST FOUR WITNESSES. IF IN DISAGREEMENT WITH PREVIOUSLY ESTABLISHED CORNER, SHOW THE DISTANCES BETWEEN THE TWO CORNERS AND ALSO INDICATE THE TIE TO THE DISPUTED CORNER.

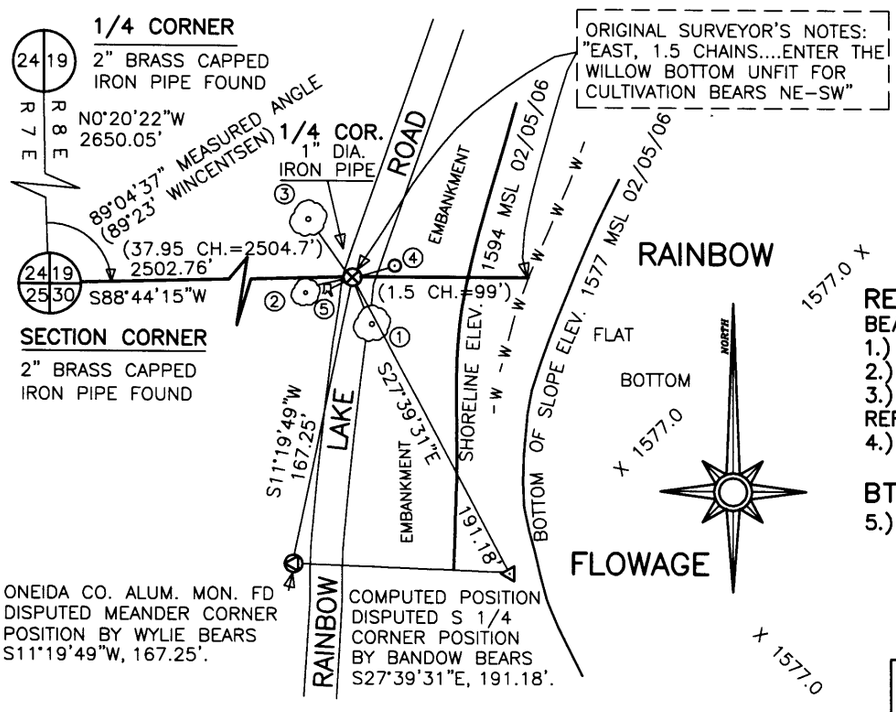

REFERENCE MONUMENTS MADE:
BEARING TREES:
1.) 19" W. PINE - S22°E, 29.15'
2.) 15" R. PINE - S72°W, 24.74'
3.) 16" W. PINE - N36°W, 41.16'
REFERENCE PIPE SET:
4.) 3/4" X 22" I. PIPE - N74°E, 24.55'

BT'S FOUND:
5.) REMAINS OF OLD PINE STUMP BEARS S66°W, 14.5'

NOTES:
1) DISTANCES TO NEW BT'S ARE MEASURED TO NAIL ON SIDE OF TREE
2) NOT TO SCALE

I STEPHEN J. FAVORITE, REGISTERED LAND SURVEYOR NO. 1616, HEREBY CERTIFY THAT THE CORNER LOCATION ON THIS RECORD WAS REFERENCED BY ME OR UNDER MY DIRECTION AND CONTROL AND THAT THIS U.S. PUBLIC LAND SURVEY MONUMENT RECORD IS COMPLETE TO THE BEST OF MY KNOWLEDGE AND BELIEF.

Stephen J. Favorite 02-13-06

SIGNATURE DATE

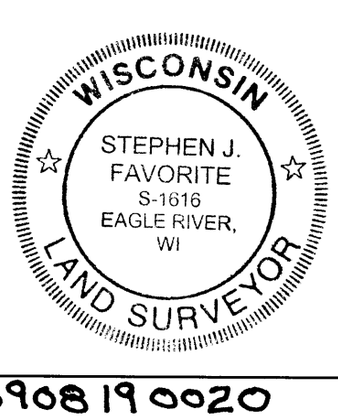

INDEX NO. R 3

3908190020