U.S. PUBLIC LAND SURVEY MONUMENT RECORD

Note: This form is intended and designed to fulfill all requirements of the Wisconsin Administrative Code, Chapter A-E 7.08 U.S. Public Land Monument Record (3)(a)(b)(c)(d)(e)(f)(g)(h)(i). An additional sheet may be added if necessary to confrom with said requirements.

(a) CORNER LOCATION:

Menader Corner on north line of Section 26
Township 39 North
Range 8 East
Town of Newbold
County of Oneida

COORDINATES

North:
East:
Control Station:
Latitude:
Longitude:
Datum Method

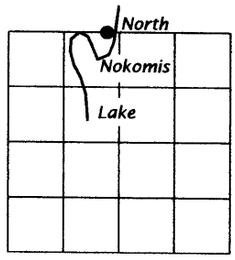

SECTION 26

(b) HISTORY OF ORIGINAL CORNER ESTABLISHMENT

Original Surveyor: A. Anderson
Date of Survey: Commenced, July, 1863
Completed, July, 1863

Original B.T.'S
Y. Pine 12" dia. S88°W 35 links
W. Pine 12" dia. N73°W 36 links

(f)(g)(h) DESCRIPTION OF MONUMENT FOUND AT THIS CORNER AND IF IT WAS ACCEPTED, STATE ALL EVIDENCE (MATERIAL, TESTIMONIAL, OCCUPATIONS, PLATS, RECORDS, OTHER MONUMENTS) USED AS A BASISFOR ESTABLISHING LOCATION. IF NOT ACCEPTED OF IF NOTHING WAS FOUND, STATE EVIDENCE USED AS BASIS FOR ESTABLISHING LOCATION. IF REESTABLISHED THROUGH LOST CORNER PROPORTIONATE METHODS, INDICATE ALL MONUMENTS, DISTANCES AND DIRECTIONS USED TO ESTABLISH. INDICATE TYPE OF MONUMENT AND SIGN POST FOUND OR SET.

Original Surveyor: A. Anderson, west corrected between Sections 23 and 26, at 46.87 chains over lake and set meander post.

Robert Ilg: Wisconsin Conservation Department, 1964, at 33.021 chains set W.C.D. pipe 10' west of lake, and makes the following bearing trees, MR 5" N81W 0.301 chains and a PN 16" dia. N11W 0.883 chains.

Michael L. Oestreich: 12/28/04, recovered a W.C.D brass capped iron pipe 10' west of lake (leaning west, I plumbed iron pipe) and the following witnesses: a 12" dia. Maple with lower blaze N81W 19.47' and a 20" dia. Red Pine with lower blaze N10W 58.62'. I made ties as shown in the plan below.

(c)(d)(e) PLAN VIEW OF CORNER WITH TIES TO AT LEAST 4 WITNESS MONUMENTS. IF IN DISAGREEMENT WITH PREVIOUSLY ESTABLISHED CORNER, SHOW THE DISTANCE BETWEEN THE TWO CORNERS AND ALSO INDICATE THE TIES TO THE DISPUTED CORNER.

Bearings magnetic

Scale 1"= 20'

Measurement to trees taken to 8d aluminum nail in the side of tree.

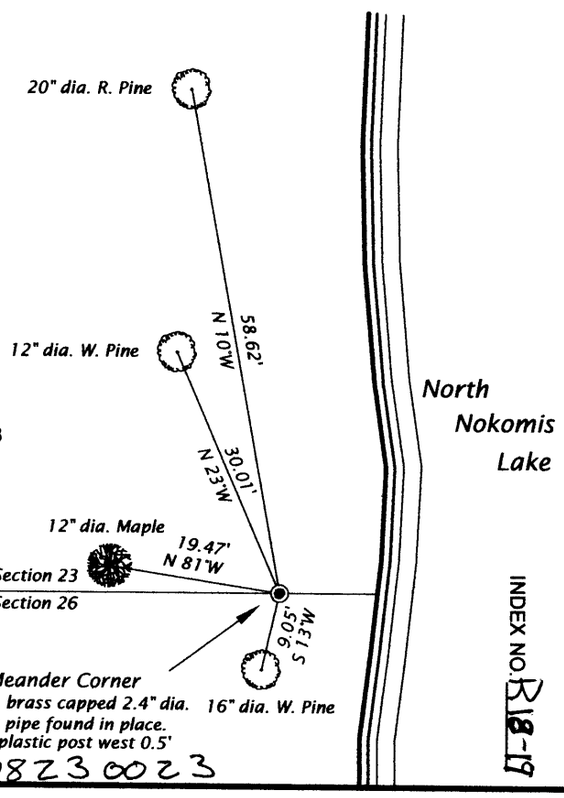

(i) I, MICHAEL L. OESTREICH, REGISTERED LAND SURVEYOR NO. S-2118 HEREBY CERTIFY THAT THE CORNER LOCATION ON THIS RECORD WAS DETERMINED BY ME OR UNDER MY DIRECTION AND CONTROL AND THAT THIS U.S. PUBLIC LAND SURVEY MONUMENT RECORD IS CORRECT AND COMPLETE TO THE BEST OF MY KNOWLEDGE AND BELIEF.

Michael L Oestreich 1/11/05

SIGNATURE DATE

INDEX NO. R18-19

3908230023