


U.S. PUBLIC LAND SURVEY MONUMENT RECORD

Note: This form is intended and designed to fulfill all requirements of Wisconsin Administrative Code, Chapter A-E 7.08 U.S. Public Land Survey Monument Record (3) (a) (b) (c) (d) (e) (f) (g) (h) (i). An additional sheet may be added if necessary to conform with said requirements.

(a) Corner location: Township 39 North
 Range 8 East/West

Town/City/Village Newbold
 County Oneida

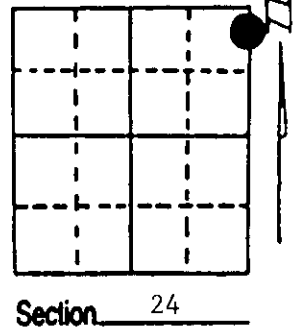

(b) (f) (g) (h) Description of monument found at this corner and if it was accepted, state all evidence (material, testimonial, occupational, plats, records, other monuments) used as a basis for accepting. If not accepted or if nothing was found, state evidence used as basis for establishing location. If reestablished through lost corner proportionate methods, indicate all monuments, distances and directions used to establish. Indicate type of monument found or set and sign post.

7/21/1863 - Alexander Anderson conducted a resurvey of this Range Line and at 77.65 chains intersected the South shore of a lake, set a wood post as the Meander Corner with two BTs:
 9" Birch, S24°E, 23 Links (15.18') 9" Birch, S9½°W, 40 Links (26.40')


1931 - C.W. Fisher restored this corner in the survey to construct the Plat known as "Donelda Play Grounds". He placed a 6" x 6" x 30" concrete monument for this corner.

5/29/1996 - Milo E. Stefan found Fisher's monument and restored it by placing an aluminum monument alongside the concrete, stamping it to identify same and took four new BTs and placed a plastic sign post.
 Due to the concrete monument being disturbed, I set an aluminum monument at the correct corner location.

(c) (d) (e) Plan view of corner with ties to at least 4 witness monuments. If in disagreement with previously established corner, show the distances between the two corners and also indicate the ties to the disputed corner.

- 1) 2" x 30" Aluminum monument/6" x 6" Concrete along side.
- 2) 6" White Pine, N82°E, 8.49'.
- 3) 5" Red Oak, S14°E, 24.77'.
- 4) 8" White Pine, S28°W, 36.02'.
- 5) 10" White Pine, S72°W, 4.35'.
- 6) Plastic Sign Post, North, 1.2'

Distances from nail in side of BTs
 Stump blaze scribed "BT"
 BT tags on face of each BT

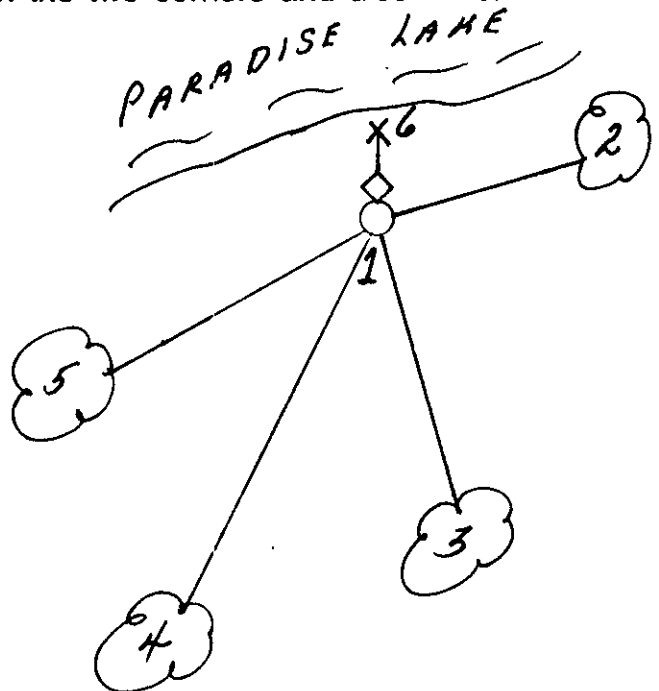

(i) I, Milo E. Stefan
 (type or print name) certify that the corner location on this record was determined by me or under my direction and control and that this U.S. Public Land Survey Monument Record is correct and complete to the best of my knowledge and belief.

Milo E. Stefan
 Signature

June 19, 1996
 Date

Milo E. Stefan
 SURVEYOR
 3908243900
 Stamp