U.S. PUBLIC LAND SURVEY MONUMENT RECORD

Note: This form is intended and designed to fulfill all requirements of Wisconsin Administrative Code, Chapter A-E 7.08 U.S Public Land Survey Monument Record (3) (a) (b) (c) (d) (e) (f) (g) (h) (i). An additional sheet may be added if necessary to conform with said requirements.

(a) Corner location: Township 39 North **Corner:** NW Section Corner

Section 33 Range 8 East **Original Surveyor:** A. Anderson

~~Town/City/Village~~ Newbold **Original B.T.'s:** 12" A N53°E 17 lks
20" Py S71°W 48 lks

County Oneida

Original Survey Date: July 1863

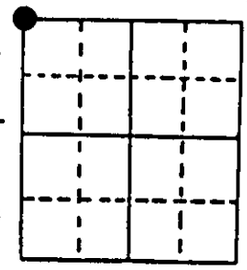

(b) (f) (g) (h) Description of monument found at this corner and if it was accepted, state all evidence (material, testimonial, occupational, plats, records, other monuments) used as a basis for accepting. If not accepted or if nothing was found, state evidence used as basis for establishing location. If reestablished through lost corner proportionate methods, indicate all monuments, distances and directions used to establish. Indicate type of monument found or set and sign post.

Old rusted 2" dia. iron pipe monument found and accepted at this corner location with no cap top 18" above existing grade. I carefully removed the 48" long iron pipe monument and reset the corner location with a standard 2" dia. x 48" long iron pipe monument with stamped DNR brass cap 17" above grade, and set a standard white poly 'T' corner marker post 1' North of corner monument. Original GLO corner post and NE Aspen OBT are now obliterated, but I found a decayed pine stump of what I believed to be the original 20" Py OBT S71°W 48 lks at S77°W 31.7', with charred root crown and evidence of axe work; I set a standard Oneida Co. DND plate on East face. In 1938, Wisconsin Valley Improvement Company set the 2" dia. iron pipe monument found at corner, and noted a 30" Pw stump BT S43°W 0.682, now decayed, and a 8" Oak BT S79°E 0.294 ch, which I found as 17" Or with upper blaze shut and lower blaze open and plain. In 1977, Lee Andreas/WVIC, found the 2½" dia. iron pipe OK at corner and noted the 1938 SE Oak BT at S78°E 24' by pacing, and that corner was about 1 chain south of CTH 'D' and SE of the WVIC sand & gravel pit. I left the old iron pipe monument found flat on ground next to new iron pipe monument set. Corner is easily accessed by vehicle and on foot. Recovery completed August 6, 1997; no witnesses.

(c) (d) (e) Plan view of corner with ties to at least 4 witness monuments. If in disagreement with previously established corner, show the distances between the two corners and also indicate the ties to the disputed corner.

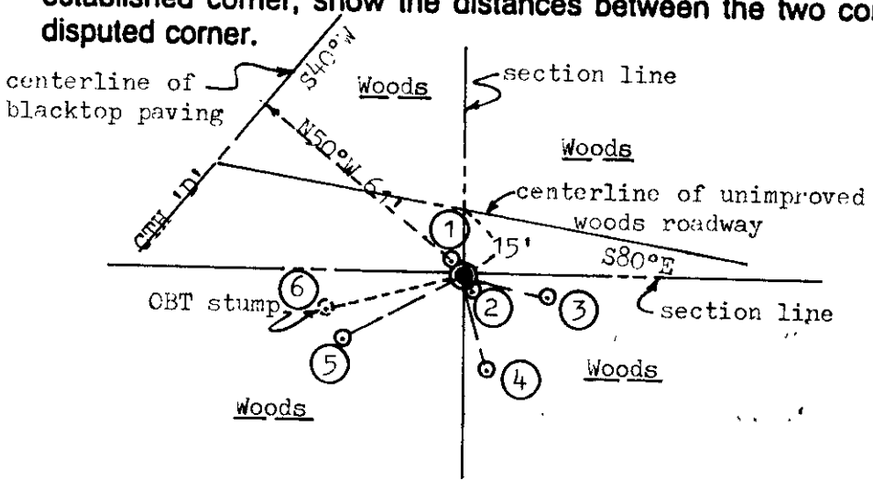

Witness Monument Ties:

1. Old BT 9" Or N43°W 4.19'.
2. New BT 11" Aspen S30°E 4.02'; WCD Aluminum locator plate fd on North face 5' high.
3. Record BT 17" Or S77°E 19.42'.
4. New BT 12" Or S14°E 21.95'; North trunk of twin.
5. New BT 13" Or S62°W 31.17'.
6. OBT stump S77°W 31.7' to old face; fire charred, signs of axe work.

Unless otherwise indicated, all BT witness monument ties are to a 1/4" dia. by 2.5" long PK nail with 1.25" dia. steel washer set in unblazed right face bark; and a PK nail with 2" dia. steel washer stamped BT also set in unblazed front face bark of each BT at DBH. All previous corner recovery notes from Wisconsin DNR and/or Oneida County survey records.

N **Scale:** 1" = 40'

(i) I, William C. Rohde, RLS 841
(type or print name) **certify that the corner location on this record was determined by me or under my direction and control and that this U.S. Public Land Survey Monument Record is correct and complete to the best of my knowledge and belief.**

WISCONSIN
WILLIAM C. ROHDE
S-0841
Boulder Junction
Wisconsin
LAND SURVEYOR

Signature

August 23, 1997
Date

Index No. V-9

SHEET 1 OF 1

39082900000