U.S. PUBLIC LAND SURVEY MONUMENT RECORD

Note: This form is intended and designed to fulfill all requirements of the Wisconsin Administrative Code, Chapter A-E 7.08 U.S. Public Land Monument Record (3)(a)(b)(c)(d)(e)(f)(g)(h)(i). An additional sheet may be added if necessary to confrom with said requirements.

(a) CORNER LOCATION:

south quarter corner, Section 33
Township 39 North
Range 8 East
Town of Newbold
County of Oneida

COORDINATES

North:
East:
Control Station:
Latitude:
Longitude:
Datum Method

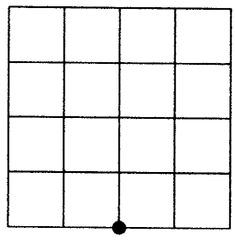

SECTION 33

(b) HISTORY OF ORIGINAL CORNER ESTABLISHMENT

Original Surveyor: A. Millard
Date of Survey: Commenced, August, 1860
Completed, September, 1860

Original B.T.'S
Y. Pine 18" dia. N33°W 11 links
Y. Pine 16" dia. S33°E 41 links

(f)(g)(h) DESCRIPTION OF MONUMENT FOUND AT THIS CORNER AND IF IT WAS ACCEPTED, STATE ALL EVIDENCE (MATERIAL, TESTIMONIAL, OCCUPATIONS, PLATS, RECORDS, OTHER MONUMENTS) USED AS A BASISFOR ESTABLISHING LOCATION. IF NOT ACCEPTED OF IF NOTHING WAS FOUND, STATE EVIDENCE USED AS BASIS FOR ESTABLISHING LOCATION. IF REESTABLISHED THROUGH LOST CORNER PROPORTIONATE METHODS, INDICATE ALL MONUMENTS, DISTANCES AND DIRECTIONS USED TO ESTABLISH. INDICATE TYPE OF MONUMENT AND SIGN POST FOUND OR SET.

Original Surveyor: A. Millard, west between Sections 4 and 33, at 40 chains set quarter section post.

Robert Ilg: Wisconsin Conservation Department, Spring 1964, set W.C.D. pipe nest to iron pipe by H. Hall. He notes 2 original bearing tree stumps, and makes new bearing tree, OR" S2E 46 ¼ links, and a sharp notch on a 2' boulder N82E 19 links.

John H. Fisher: Northwoods Surveyors, Inc., shows quarter corner to be monumented with a W.C.D. brass capped iron pipe, and witnessed by the following bearing trees: 9" Oak S4E 30.7' and a White Pine stump S32E 27.2'.

Frederic H. Copp: Department of Natural Resources, 5/24/77, shows quarter corner to be a 4" dia. iron pipe with a W.C.D. brass capped iron pipe next to said pipe, and witnessed by the following bearing tree, OR 9" S2E 30.5' and a sharp notch on top of 2' boulder N82E 12.5'.

Michael L. Oestreich: 9/07/02, recovered a W.C.D brass capped iron pipe, with a 3.5" dia. iron pipe adjacent to it, and the following witnesses: a 12" dia. Oak S2E 31.00', a notch on an approximate 2' dia. boulder N80E 13', a badly decayed stump, bearing and distance to approximate center of stump N33W 8.2', and a decaying stump with ax marks and scribing still visible bearing and distance to approximate center of stump S36E 27.7' I made ties as shown in the plan below.

(c)(d)(e) PLAN VIEW OF CORNER WITH TIES TO AT LEAST 4 WITNESS MONUMENTS. IF IN DISAGREEMENT WITH PREVIOUSLY ESTABLISHED CORNER, SHOW THE DISTANCE BETWEEN THE TWO CORNERS AND ALSO INDICATE THE TIES TO THE DISPUTED CORNER.

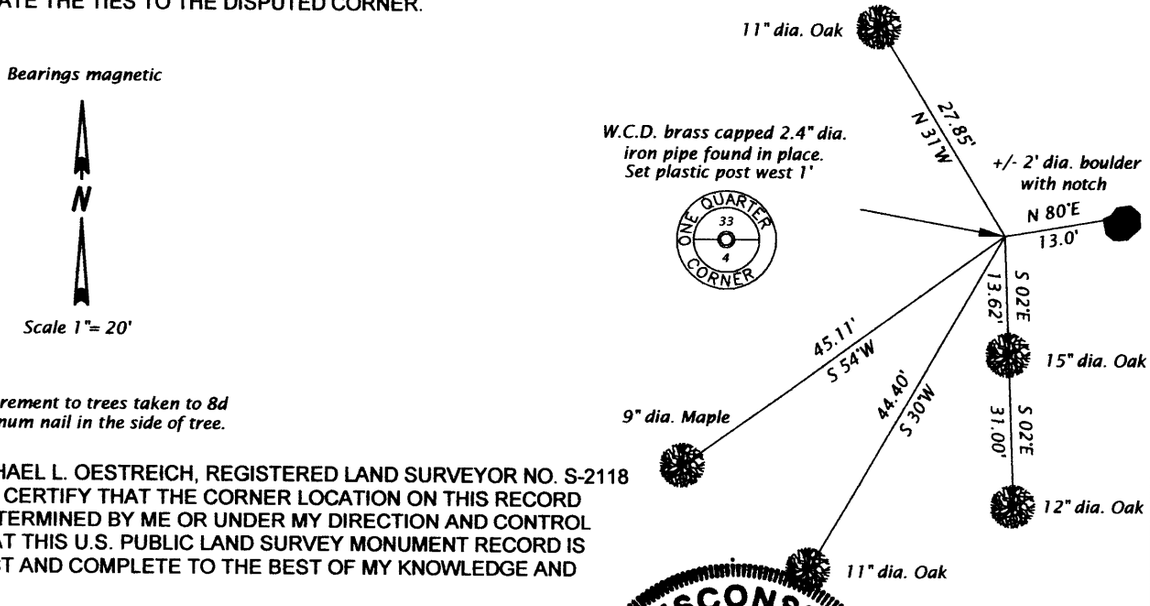

Measurement to trees taken to 8d aluminum nail in the side of tree.

(i) I, MICHAEL L. OESTREICH, REGISTERED LAND SURVEYOR NO. S-2118 HEREBY CERTIFY THAT THE CORNER LOCATION ON THIS RECORD WAS DETERMINED BY ME OR UNDER MY DIRECTION AND CONTROL AND THAT THIS U.S. PUBLIC LAND SURVEY MONUMENT RECORD IS CORRECT AND COMPLETE TO THE BEST OF MY KNOWLEDGE AND BELIEF.

Michael L Oestreich 1/11/05
SIGNATURE DATE

WISCONSIN
MICHAEL L.
OESTREICH
S-2118
MINOCQUA,
WI
LAND SURVEYOR

INDEX NO. Z 11

3908330020