

CERTIFIED LAND CORNER RESTORATION

Index No. **E-16**

State of Wisconsin


County of Oneida } ss.

History of original corner establishment:  
Corner established by R. Ilg, Registered Surveyor, DNR Survey of 1971.

I Philip T. Hansen, do hereby certify that on the 22nd day of April, 1975, I found evidence of the E-1/16 corner of Sections 3 and 10 Township 39 North, Range 9 East, Fourth Principal Meridian, as described hereon; and that from this evidence I established a new monument and accessories as described hereon to perpetuate the original location of this corner.


Description of corner evidence found:  
Recovered 1 1/2" O.D. iron pipe, painted red, no brass cap.  
Recovered ORT's - White birch S180E 53 links scribed 'W' 1/8 BT  
Red oak S540W 47.6 links scribed 'W' 1/8 BT

Resident witnesses:

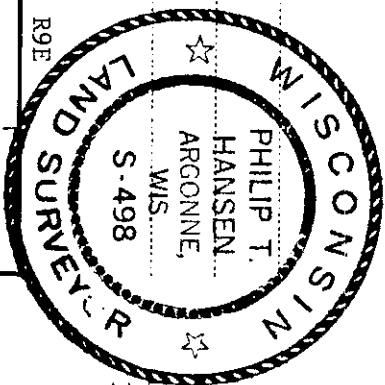

Description of monument and accessories I established to perpetuate the original location of this corner.  
Replaced 1 1/2" iron pipe with 1 1/2" O.D. iron pipe with 2" brass cap stamped -

S-498  
T39N, R9E  
E-1/16 S13 S110  
CPI-1975

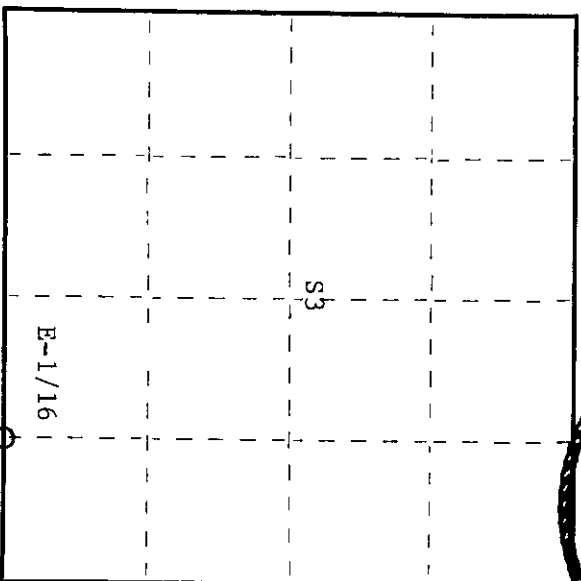

○ = Corner monument restored.

Dated at Rhinelander, Wis., this 8th day of May, 1975.

Signature *Philip T. Hansen* Title Registered Land Surveyor Registration No. S-498  
(County Surveyor, Registered Land Surveyor, or other duly authorized official)

Office of Register of Deeds, County of Oneida  
Instrument was filed in this office for record on the 1st day of October, 1975, at 3:00 o'clock P.M.

*Dorcas Virginia Kuehn*  
(Register of Deeds)

By: Deputy

3909030010