


U.S. PUBLIC LAND SURVEY MONUMENT RECORD

Note: This form is intended and designed to fulfill all requirements of Wisconsin Administrative Code, Chapter A-E 7.08 U.S. Public Land Monument Record (3)(a)(b)(c)(d)(e)(f)(g)(h)(i). An additional sheet may be added if necessary to conform with said requirements.

(a) CORNER LOCATION: East County or State Plane Coordinates
1/4 Corner of Section 8 Northing _____
 Township 39 North Easting _____
 Range 9 East Datum Base _____
 Township/City Sugar Camp County of Oneida

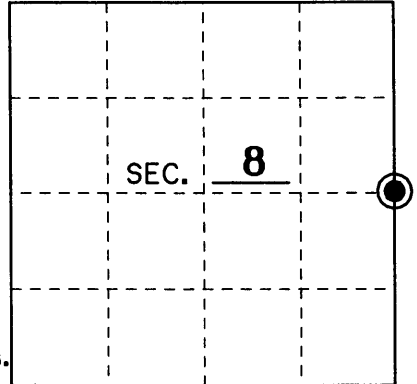

(b) HISTORY OF ORIGINAL CORNER ESTABLISHMENT Original B.T.'s
 Original Surveyor: William Daugherty 8" Spruce S 64°W 3 Lks.
 Date of Survey: September, 1863 20" Y. Pine N 79°E 22 Lks.

(b)(f)(g)(h) Description of monument found at this corner and if it was accepted, state all evidence (material, testimonial, occupational, plats, records, other monuments) used as a basis for accepting. If not accepted or if nothing was found, state evidence used as basis for establishing location. If reestablished through lost corner proportionate methods, indicate all monuments, distances and directions used to establish. Indicate type of monument and sign post found or set.


September, 1863: William Daugherty set a wood post for the original corner in his survey of T 39 N, R 9 E. He also made two B.T.'s as noted above.

1938: Wisconsin Valley Improvement found the original post and one old B.T. stump at the 1/4 corner position in their survey of Section 8. They replaced the post with a 2" iron pipe and made two new B.T.'s as shown below.

6-06-2006: I, James L. Will, of Eagle Landmark Surveying found a 2" iron pipe 2.3 feet high 10 feet East of the swamp at the East 1/4 corner of Section 8. I also found both of Wisconsin Valley Improvement B.T.'s, as shown below. I replace the 2" iron pipe with a 2" x 36" Oneida County aluminum monument stamped to identify the corner as shown below. I made three new B.T.'s and set a sign post 1 foot North.


(c)(d)(e) Plan view of the corner with ties to at least 4 witness monuments. If in disagreement with previously established corner, show the distances between the two corners and also indicate the ties to the disputed.

SCALE: 1" = 20'

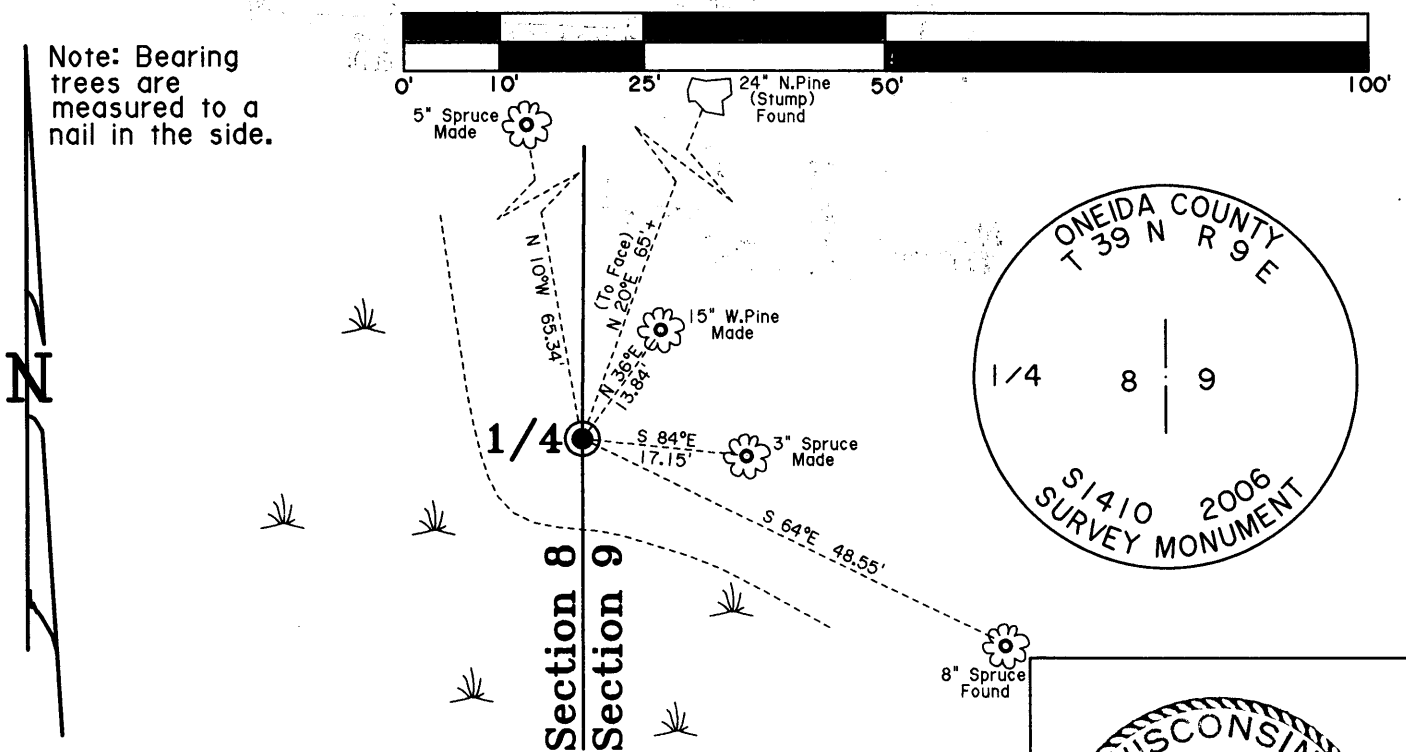

(i) I, James L. Will R.L.S. No. 1410
 hereby certify that the corner location on this record was determined by me or under my direction and control and that this U.S. Public Land Survey Monument Record is correct and complete to the best of my knowledge and belief.

Signature *James L. Will* Date 6-06-2006

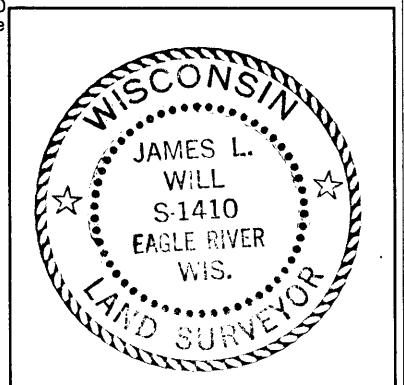

3909082000

Index No. G-9