


U.S. PUBLIC LAND SURVEY MONUMENT RECORD

Note: This form is intended and designed to fulfill all requirements of Wisconsin Administrative Code, Chapter A-E 7.08 U.S. Public Land Monument Record (3)(a)(b)(c)(d)(e)(f)(g)(h)(i). An additional sheet may be added if necessary to conform with said requirements.

(a) CORNER LOCATION: _____ County or State Plane Coordinates
West 1/4 Corner of Section 11 Northing _____
 Township 39 North Easting _____
 Range 9 East Datum Base _____
 Township/City Sugar Camp County of ONEIDA

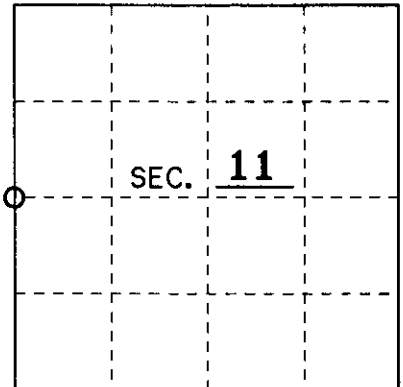

(b) HISTORY OF ORIGINAL CORNER ESTABLISHMENT Original B.T.'s
 Original Surveyor: William E. Daugherty 10" Birch S 75°E 5 lks.
 Date of Survey: September 1863 10" Birch S 86°W 31 lks.

(b)(f)(g)(h) Description of monument found at this corner and if it was accepted, state all evidence (material, testimonial, occupational, plats, records, other monuments) used as a basis for accepting. If not accepted or if nothing was found, state evidence used as basis for establishing location. If reestablished through lost corner proportionate methods, indicate all monuments, distances and directions used to establish. Indicate type of monument and sign post found or set.


1972: Robert Ilg set a DNR monument for the corner and listed the following bearing trees: 12" W. Pine S 61°W 34.39'; 12" Red Oak S 75°W 110.75'; 13" W. Pine N 49°W 18.22'

January, 1977: Fred Copp of the DNR used Ilg's corner and found his bearing trees

Aug. 1985: William Rhode of the DNR used Ilg's corner and found his bearing trees.


12/3/2001: I, Michael E. Weber found Ilg's iron pipe brass cap and bearing trees as shown below. I also made one new bearing tree and set a plastic sign post 1 foot northwest of the corner.

(c)(d)(e) Plan view of the corner with ties to at least 4 witness monuments. If in disagreement with previously established corner, show the distances between the two corners and also indicate the ties to the disputed.

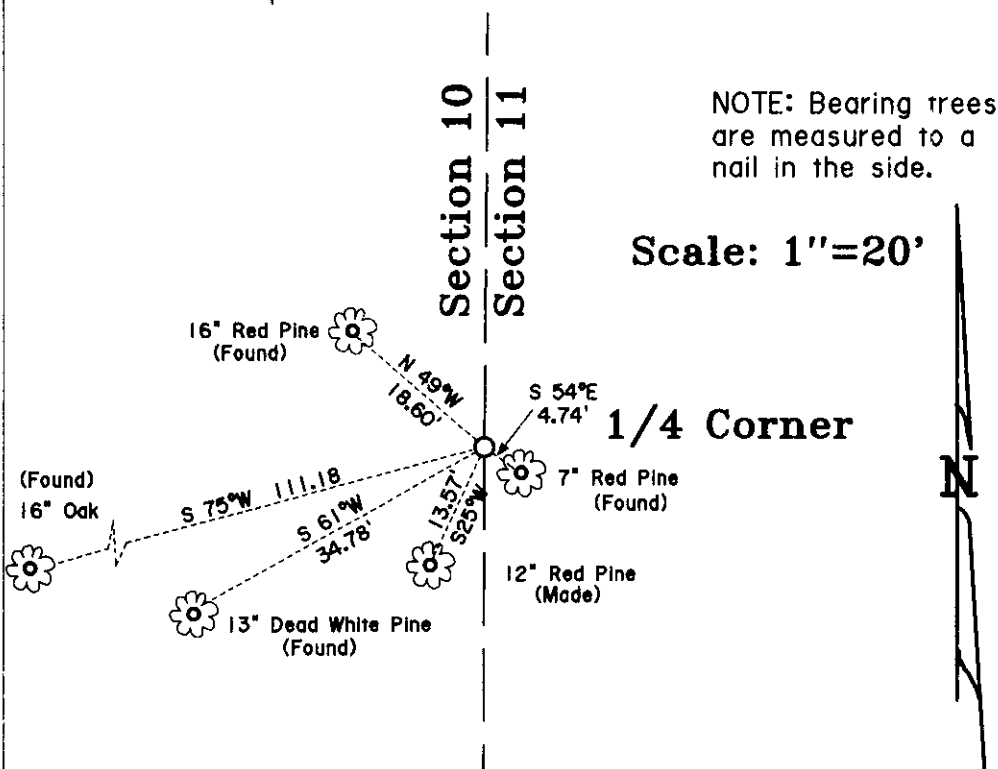


NOTE: Bearing trees are measured to a nail in the side.

Scale: 1"=20'

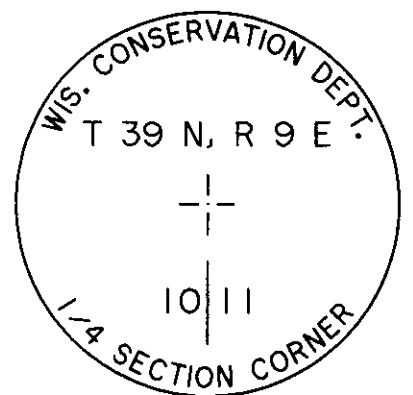

(i) I, Michael E. Weber R.L.S. No. 2070
 hereby certify that the corner location on this record was determined by me or under my direction and control and that this U.S. Public Land Survey Monument Record is correct and complete to the best of my knowledge and belief.

Signature Michael E. Weber Date 12/3/2001

 

Index No. G-17

3909102000