


U.S. PUBLIC LAND SURVEY MONUMENT RECORD

Note: This form is intended and designed to fulfill all requirements of Wisconsin Administrative Code, Chapter A-E 7.08 U.S. Public Land Survey Monument Record (3) (a) (b) (c) (d) (e) (f) (g) (h) (i). An additional sheet may be added if necessary to conform with said requirements.

(a) **Corner location:** Township 39 North Corner: North 1/4 Corner
 Section 23 Range 9 East Original Surveyor: W. Daugherty
 Town/City/Village Sugar Camp Original B.T.'s: 10" Bw S08°E 11 lks
 County Oneida 10" Bw N57°W 22 lks

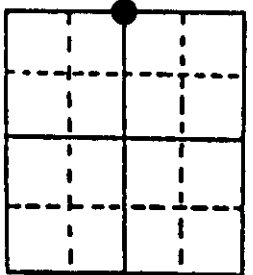


Original Survey Date: September 1863 ● Location

(b) (f) (g) (h) **Description of monument found at this corner and if it was accepted, state all evidence (material, testimonial, occupational, plats, records, other monuments) used as a basis for accepting. If not accepted or if nothing was found, state evidence used as basis for establishing location. If reestablished through lost corner proportionate methods, indicate all monuments, distances and directions used to establish. Indicate type of monument found or set and sign post.**

Found and accepted standard 2" dia. iron pipe monument with stamped WCD brass cap at this corner location; I carefully removed the 50" long monument with flat steel soil anchor rod welded to bottom end, and set it deeper with cap 18" above grade, as monument was found too high above existing grade. I also set a standard white poly 'T' corner marker post 1 foot East of the reset monument. Original GLO survey corner evidence is now obliterated. WCD now DNR survey records at Trout Lake Forestry office note in 1946 that this corner monument was set 40.228 chains midway on a right line between section corners. In 1988, Seymour/DNR found the "tall" brass capped monument OK and measured new ties, a 10" Bw S62°W 34.32' is now same with upper and lower face blazes open and plain, his 17" Sw N39°W 15.83' now same with upper and lower face blazes open and plain which I used for new ties below, and his 4" Aspen S65°E 2.32' is now 8" S63°E with upper and lower face blazes shut but plain which I also used for new ties below. This recovery completed July 9, 1997; no witnesses.


(c) (d) (e) **Plan view of corner with ties to at least 4 witness monuments. If in disagreement with previously established corner, show the distances between the two corners and also indicate the ties to the disputed corner.**

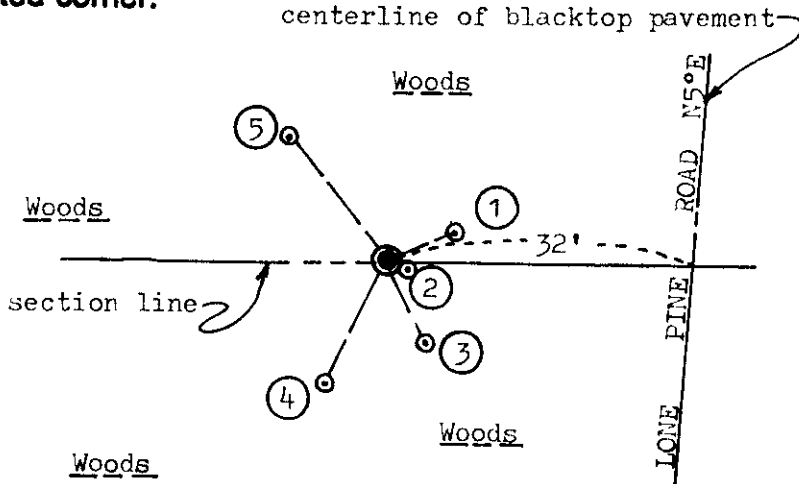

- Witness Monument Ties:**
- ① New BT 5" Sb N69°E 7.35'.
 - ② Record BT 8" Aspen S63°E at 2.50'.
 - ③ New BT 5" Sb S23°E 9.55'.
 - ④ New BT 4" Sb S26°W 14.36'.
 - ⑤ Record BT 17" Sw N39°W 16.33'.

Unless otherwise indicated, all BT witness monument ties are to a 1/4" dia. by 2.5" long PK nail with 1.25" dia. steel washer set in unblazed right face bark; and a PK nail with 2" dia. steel washer stamped BT also set in unblazed front face bark of each BT at DBH. All previous corner recovery notes from Wisconsin DNR and/or Oneida County survey records.

Scale: 1" = 20'

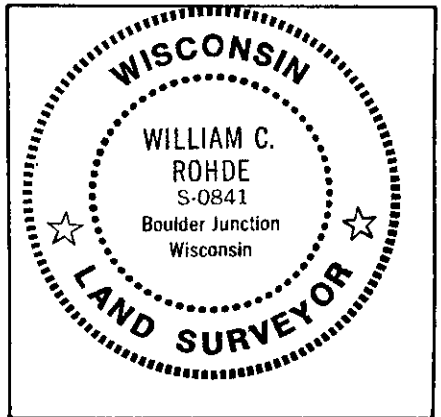

(i) I, William C. Rohde, RLS 841
 (type or print name) certify that the corner location on this record was determined by me or under my direction and control and that this U.S. Public Land Survey Monument Record is correct and complete to the best of my knowledge and belief.

William C. Rohde Signature July 13, 1997 Date

Index No. N 19