U.S. PUBLIC LAND SURVEY MONUMENT RECORD

Note: This form is intended and designed to fulfill all requirements of Wisconsin Administrative Code, Chapter A-E 5.02, U.S. Public Land Survey Monument Record (3) (a) (b) (c) (d) (e) (f) (g) (h) (i). An additional sheet may be added if necessary to conform with said requirements.

(a) Corner location: Township 39 North

Range 9 East/~~West~~

Town/~~City/Village~~ Sugar Camp

County Oneida

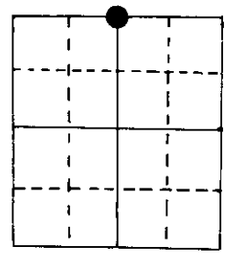

Section 22

(b) (f) (g) (h) Description of monument found at this corner and if it was accepted, state all evidence (material, testimonial, occupational, plats, records, other monuments) used as a basis for accepting. If not accepted or if nothing was found, state evidence used as basis for establishing location. If reestablished through lost corner proportionate methods, indicate all monuments, distances and directions used to establish.

Orig. Post Set By Wm. E. Daugherty Sept. 24, 1863

BTs White Pine 30 N61°E 19 lks

Birch 10 N42°W 4 lks

Found 2" Capped Iron Pipe

BTs Present	PW	12"	S 26° E	24.80'
	PR	6"	S 58° W	8.60'
Mkd. New	PW	14"	N 45° E	41.70'
	MR	6"	N 39° W	23.73'

(c) (d) (e) Plan view of corner with ties to at least 4 witness monuments. If in disagreement with previously established corner, show the distances between the two corners and also indicate the ties to the disputed corner.

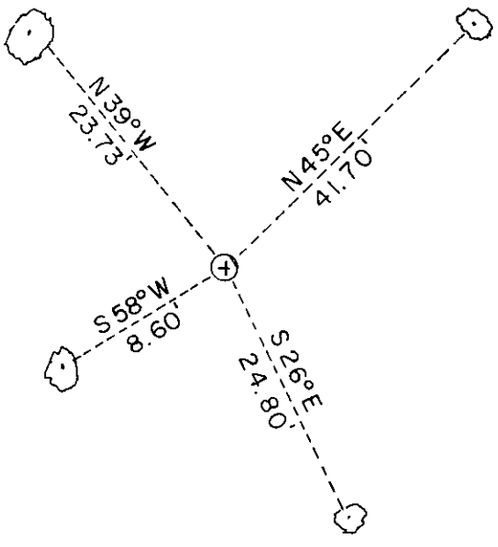

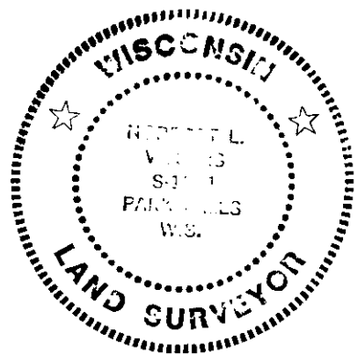

(i) I, Norbert L. Vissers
(type or print name) certify that the corner location on this record was determined by me or under my direction and control and that this U.S. Public Land Survey Monument Record is correct and complete to the best of my knowledge and belief.

Affix seal here

Norbert L. Vissers March 27, 1985

Signature Date

N-15

3909 150020