

At _____ O'Clock _____ M
THOMAS H. LEIGHTON

This form is intended to fulfill the requirements of Chapter A-E7.08 (3)(a) thru (f) U.S. Public Land Survey Monument Location Record, Wisconsin Administrative Code. Use the reverse side of form for continuation.

U.S. PUBLIC LAND SURVEY MONUMENT LOCATION RECORD

Recorders Data

USPLS CORNER: NORTH WITNESS MC SECTION: 17 TOWNSHIP: 39 NORTH RANGE: 9 EAST

NAME OF WATERWAY FOR M.C. CORNER: DAM LAKE SECTION LINE: WEST

~~(CITY)(VILLAGE)(TOWN)~~ OF: SUGAR CAMP COUNTY OF: ONEIDA

Description of monument found or placed and all other evidence used as the basis for monument location; including monuments and measurements required if the corner location was reestablished by lost corner proportionate methods. Also indicate name of the original surveyor, original survey date and the corner monument, bearing trees, witness or other reference monuments established, including measured bearing and distance ties, from available survey records.

No original wood post set or BT's marked by GLO survey as Dam Lake impounded by daming since.

In October 2003, Michael E. Weber/RLS 2070 notes a 1.5" dia. iron pipe at this witness MC per his Plat of Survey filed as A-1269 in Oneida County survey records. He also noted that an MC by M.C. Tuttle in 1946 bears N73°44'21"E 16.67', which I could not find any monumentation evidence of.


I found and accepted an old 1.5" dia. iron pipe with uncapped top 4" above grade at this MC location per Plat of Survey A-1269 and drove a standard 2" dia. x 10" long aluminum monument with stamped Oneida County cap over the old iron pipe to 5" above grade and placed rocks around the monument as a cairn. I also found a 1/2" x 2.5" yellow poly marker stake 12" South and drove a standard white poly 'T' post along West side of the marker stake.

Corner falls 13'+/- North of OHWM along lakeshore bearing N70°E at bottom of a steep slope up to the North and at the SE corner of improved lake lot at Fire No. 5177 Dam Lake Road.

There were no direct witnesses.

Recovery completed June 27, 2006.

Plan view map of monument location with bearing and distance ties to a minimum of four(4) described witness or reference monuments of concrete, natural stone, iron, live bearing trees or equivalent material. If applicable, also show a minimum of two(2) bearing and distance ties to any other monument found and not accepted; including the bearing and distance from the accepted monument.

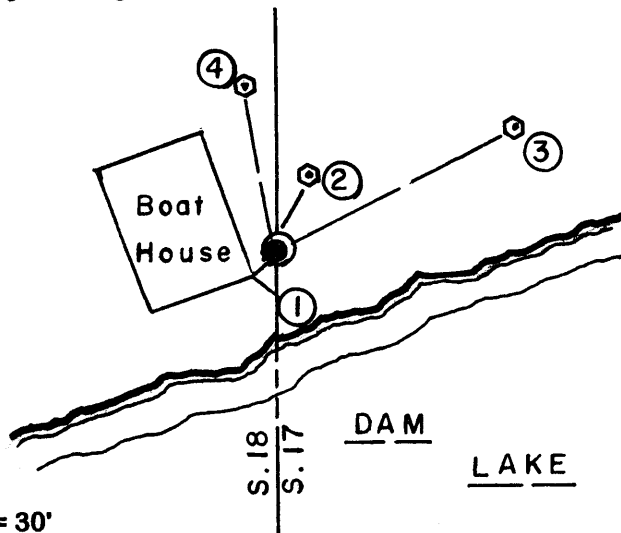


WITNESS MONUMENT TIES:

- ① SE corner of concrete block boat house S40°W 4.59'.
- ② New BT 7" East trunk of triple Oak N25°E 13.24'.
- ③ New 13" Pr BT N62°E 41.79'.
- ④ New 5" Double Mr BT N10°W 26.83' to PK /W in left face.

SCALE: 1" = 30'

Unless otherwise indicated, all bearing tree ties are to a .25" dia. by 2.5" long PK nail with a 1.25" dia. steel washer driven into unblazed right face and a .25" dia. by 2.5" long PK nail with a 2" dia. steel washer stamped BT is also driven into unblazed face of bearing tree at DBH; the basis for measured bearings is by compass to nearest degree and all tie distances are measured horizontal by steel tape corrected to nearest 1/100th feet at standard temperature of 68° F.


RLS SEAL:

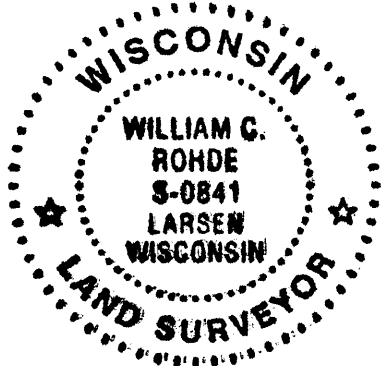

LAND SURVEYOR CERTIFICATE:

I, William C. Rohde, hereby certify that I am duly licensed as a Professional Land Surveyor in the State of Wisconsin; that this USPLS monument location was determined by me and/or under my direct supervision and control; and that this U.S. Public Land Survey Monument Location Record is true and correct to the best of my knowledge and belief.

Signed: *William C. Rohde*
William C. Rohde RLS 841

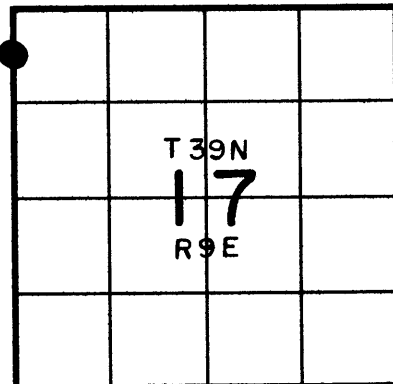

SECTION LOCATION MAP

INDEX NO. J-K 5
3909 1836 00