

CERTIFIED LAND CORNER RESTORATION

Index No. R-24

State of Wisconsin



County of Oneida } ss.

I Phillip T. Hansen, do hereby certify that on the 1st day of February, 1978, I found evidence of the E 1/16 corner of Section 24 & 25 Township 39, North, Range 9 East, Fourth Principal Meridian, as described hereon; and that from this evidence I established a new monument and accessories as described hereon to perpetuate the original location of this corner.

Resident witnesses:

Jim Clafflin

Herb Wagoner

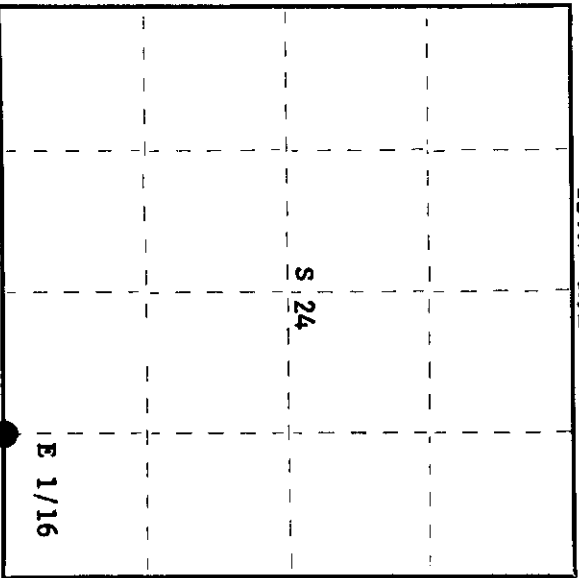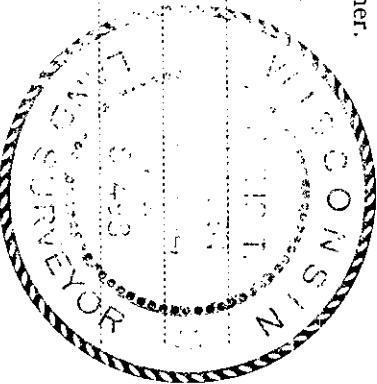

○ = Corner monument restored.

History of original corner establishment:

Corner recovered by N. Loftus, Ripco Surveyor. Ran random line west from NE corner of Section 25, bearing 264° 30' magnetic 20.32 chains, closed out 69 links south of E 1/16 corner. This was believed to have been set by Wincentzen.

Description of corner evidence found:

Recovered 5" square cedar post, scribed E 1/16 - E 1/16, in good condition.
Recovered OBT's - Cedar 7" S28 E, 13.6 links, scribed 1/16 EBT.

Cedar 7" due west, 6.6 links, scribed 1/16 EBT.
No records of these BT's.

Description of monument and accessories I established to perpetuate the original location of this corner:
Replaced wood post with 1 1/2" iron pipe with 2" brass cap, stamped:
Monument projects 12" above ground.
No additional accessories established.

S498
T39N R9E
E 1/16 S + 24
S + 25
1978

Dated at Rhineland, Wis., this 3rd day of February, 1978.

Signature Phillip T. Hansen Title Registered Land Surveyor Registration No. S-498
(County Surveyor, Registered Land Surveyor, or other duly authorized official)

Office of Registrar of Deeds, County of Oneida. I hereby certify that the within instrument was filed in this office for record on the 7th day of February, 1978 at 2:00 o'clock P. M.

Dorcas Verage Fuchman
(Register of Deeds)

By: _____ Deputy

3909240010