

CERTIFIED LAND CORNER RESTORATION

Index No. U-23

State of Wisconsin }  
County of Oneida } ss.


I Phillip T. Hansen, do hereby  
certify that on the 24th day  
of August, 1978, I found  
evidence of the SC 1/16  
corner of Section 25  
Township 39, North, Range  
9 East, Fourth Principal Meridian,

as described hereon; and that from this evidence  
I established a new monument and accessories  
as described hereon to perpetuate the original  
location of this corner.


Resident witnesses:

Jim Clafflin

Herb Wagoner

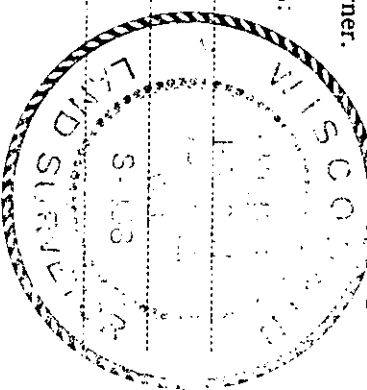

T39N R9E

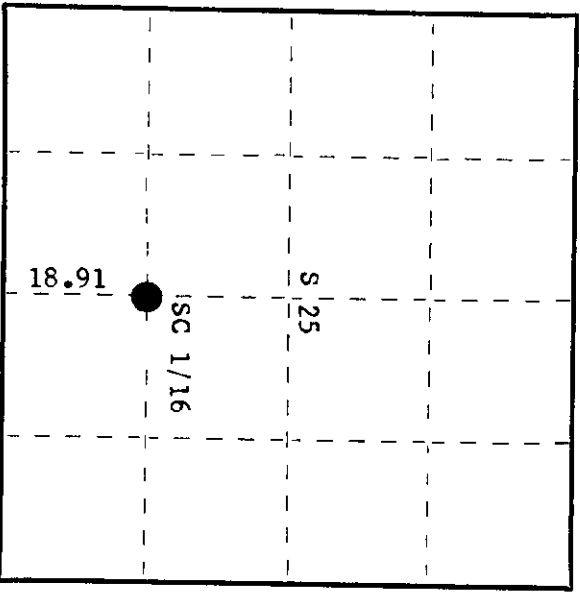

○ = Corner monument restored.

History of original corner establishment:

Corner established by Goddard and crew, Ripco surveyors.  
Ran line north, bearing 355° 30' magnetic from S 1/4 corner 77.39 chains to close out  
18 1/2 links west of N 1/4. Established C 1/4 corner at 37.82 chains.  
Set SC 1/16 at 18.91 chains intermediate.

Marked NBT's -  
Ash 14" S78°E 2.23 chains  
Aspen 12" N26°E 1.52 chains

Description of corner evidence found:

Recovered an old squared post on edge of potatoe field.  
Recovered OBT - Ash 14" S78°E 2.32 chains, our distance 1.52 chains  
Recovered OBT Aspen 12" N26°E 1.52 chains, our distance 2.32 chains  
BT's scribed C 1/16 BT. Ripco had their measurements reversed.

Description of monument and accessories I established to perpetuate the original location of this corner.

Replaced wood post with 1 1/2" iron pipe with 2" brass cap.  
Monument projects 28" - cap stamped:

Marked NBT -  
Black Spruce 4" N51°E 1.731 chains, scribed 1/16 BT.      S-498  
T39N R9E  
SC 1/16 S 25

CPI-1978

Dated at Rhineland, Wis., this 6th day of November, 1978

Signature Phillip T. Hansen Title Registered Land Surveyor Registration No. S-498  
(County Surveyor, Registered Land Surveyor, or other duly authorized official)

Office of Register of Deeds, County of Oneida  
at 1:00 o'clock P.M., I hereby certify that the within  
instrument was filed in this office for record on the 27th day of November, 1978

James George Kuehn  
(Register of Deeds)

By James George Kuehn Deputy

3909 25 10 20