

CERTIFIED LAND CORNER RESTORATION



Index No. **70-23**

3909251920

State of Wisconsin } ss.
 County of Oneida

I Phillip T. Hansen, do hereby certify that on the 24th day of August, 1978, I found evidence of the M.C. corner of N-S quarter line - Sec. 25 Township 39, North, Range 9, East, Fourth Principal Meridian, as described hereon; and that from this evidence I established a new monument and accessories as described hereon to perpetuate the original location of this corner.

Resident witnesses:
Jim Clafin
Herb Wagoner

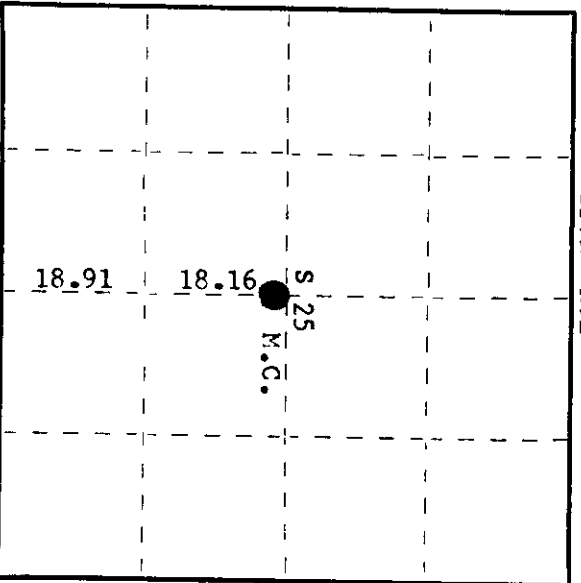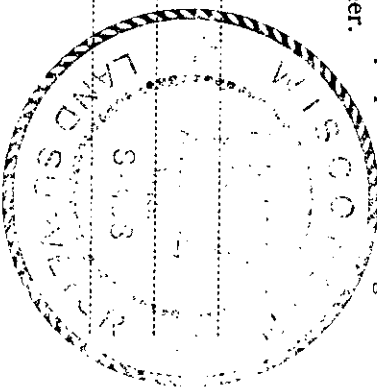

○ = Corner monument restored.

CERTIFIED LAND CORNER RESTORATION

History of original corner establishment:

Corner established by Goddard and crew, Ripco surveyors, in 1960. Ran N-S 1/4 line north bearing 355° 30' magnetic, 77.39 chains to close out 18 1/2 links west of N 1/4 corner. Established C 1/4 corner at 37.57 chains in lake, set M.C. at 37.07 chains. Marked NBT's -

Black Spruce 5" S55°W 69 links
 Black Spruce 8" S32°E 92 1/2 links

Description of corner evidence found:

Recovered 5" square spruce post, scribed C 1/4, 75 links north. Post sets 18.16 chains, N 4° 38' W of SC 1/16 corner.

Recovered BT's to C 1/4 corner -

Black Spruce 5" S55°W 69.0 links, scribed C 1/4 S25 BT.
 Black Spruce 8" S32°E 92.5 links, scribed 1/4 S25 BT.

M.C. sets on the south shore of Bog Lake.

Description of monument and accessories I established to perpetuate the original location of this corner.

Set a 2 1/2" Berntsen A-1 Federal Monument in place of the wood post.

Monument projects 2 1/2 feet. Cap stamped:

Marked NBT's -
 Black Spruce 8" N78°E 37.7 links S-498
 Black Spruce 8" S43°E 44.7 links T39N R9E
 Tamarack 6" S24°W 24.2 links
 Black Spruce 7" N74°W 19.2 links
 all scribed M.C. BT. M.C. S 25 NS 1/4
 1978

Dated at Rhineland, Wis., this 6th day of November, 1978

Signature Phillip T. Hansen Title Registered Land Surveyor Registration No. S-498
County Surveyor, Registered Land Surveyor, or other duly authorized official

Office of Register of Deeds, County of Oneida I hereby certify that the within instrument was filed in this office for record on the 24th day of August, 1978 at 11 o'clock P. M.

Debra J. Hagan (Register of Deeds)

By Debra J. Hagan Deputy