


U.S. PUBLIC LAND SURVEY MONUMENT RECORD

Note: This form is intended and designed to fulfill all requirements of Wisconsin Administrative Code, Chapter A-E 7.08 U.S. Public Land Survey Monument Record (3) (a) (b) (c) (d) (e) (f) (g) (h) (i). An additional sheet may be added if necessary to conform with said requirements.


(a) Corner location: Township 39 North
 Range 9 East/West
 Town/City/Village Sugar Camp
 County Oneida

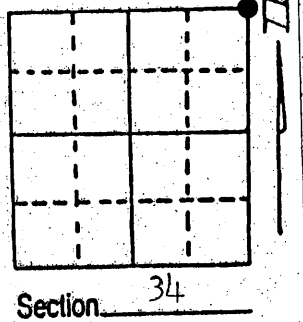

(b) (f) (g) (h) Description of monument found at this corner and if it was accepted, state all evidence (material, testimonial, occupational, plats, records, other monuments) used as a basis for accepting. If not accepted or if nothing was found, state evidence used as basis for establishing location. If reestablished through lost corner proportionate methods, indicate all monuments, distances and directions used to establish. Indicate type of monument found or set and sign post.

NE. Cor. sec. 34 original set by W.E. Daugherty June 1863.
 Dorr Found cor.. March 1892 set Bts. Birch 8 S25° E 14lks.
 " " 10 N62W 11lks.
 Relocated by Vaughn June 1914 when laying out road to South
 Ripco surveyors found evidence of scribed wood post & fence Corner
 1957 no evidence of Bts.
 We found scribed wood post & fallen fence corner replaced with
 county Mon. and white plastic signpost.

(c) (d) (e) Plan view of corner with ties to at least 4 witness monuments. If in disagreement with previously established corner, show the distances between the two corners and also indicate the ties to the disputed corner.

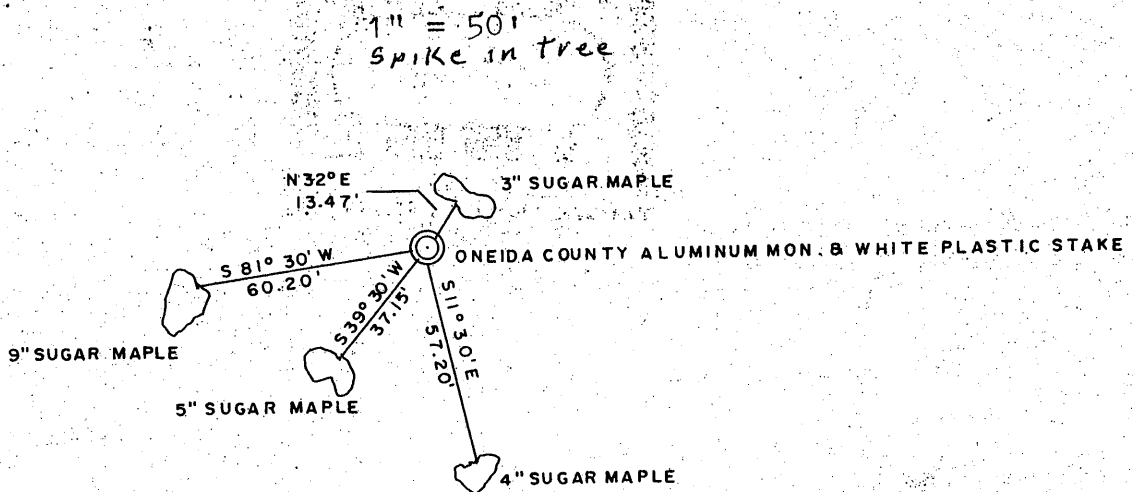

(i) I, Todd Loftus
 (type or print name) certify that the corner location on this record was determined by me or under my direction and control and that this U.S. Public Land Survey Monument Record is correct and complete to the best of my knowledge and belief.



Todd Loftus Signature
11/16/88 Date

3909270000

Index No. V-17