U.S. PUBLIC LAND SURVEY MONUMENT RECORD

Note: This form is intended and designed to fulfill all requirements of Wisconsin Administrative Code, Chapter A-E 7.08 U.S. Public Land Survey Monument Record (3) (a) (b) (c) (d) (e) (f) (g) (h) (i). An additional sheet may be added if necessary to conform with said requirements.

(a) Corner location: Township 39 North (T 38 N) Section 32 Section 5

Range 9 East/West

Town/City/Village Sugar Camp

County Oneida

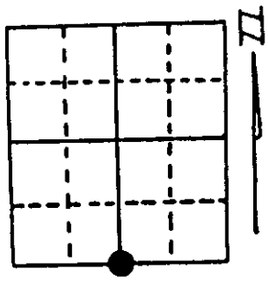

¼ corner Section 32

(b) (f) (g) (h) Description of monument found at this corner and if it was accepted, state all evidence (material, testimonial, occupational, plats, records, other monuments) used as a basis for accepting. If not accepted or if nothing was found, state evidence used as basis for establishing location. If reestablished through lost corner proportionate methods, indicate all monuments, distances and directions used to establish. Indicate type of monument found or set and sign post.

1859 H.C. Fellows set post BT's: 10" Hemlock S33°E, 40 links.
10" Fir N9°E, 15 links.

1950 BLM Dependent Resurvey by Hugh B. Crawford Cadastral Engineer replaced a found concrete post with 2"X30" brass capped iron pipe. Original BT stumps found.
BT'S made: 7" Maple NO°45'W, 22 links
5" Maple S55½°E, 28 links

1993 Found Crawfords iron pipe and BT's. Made 2 new BT'S and set carsonite post as shown on sketch below.

(c) (d) (e) Plan view of corner with ties to at least 4 witness monuments. If in disagreement with previously established corner, show the distances between the two corners and also indicate the ties to the disputed corner.

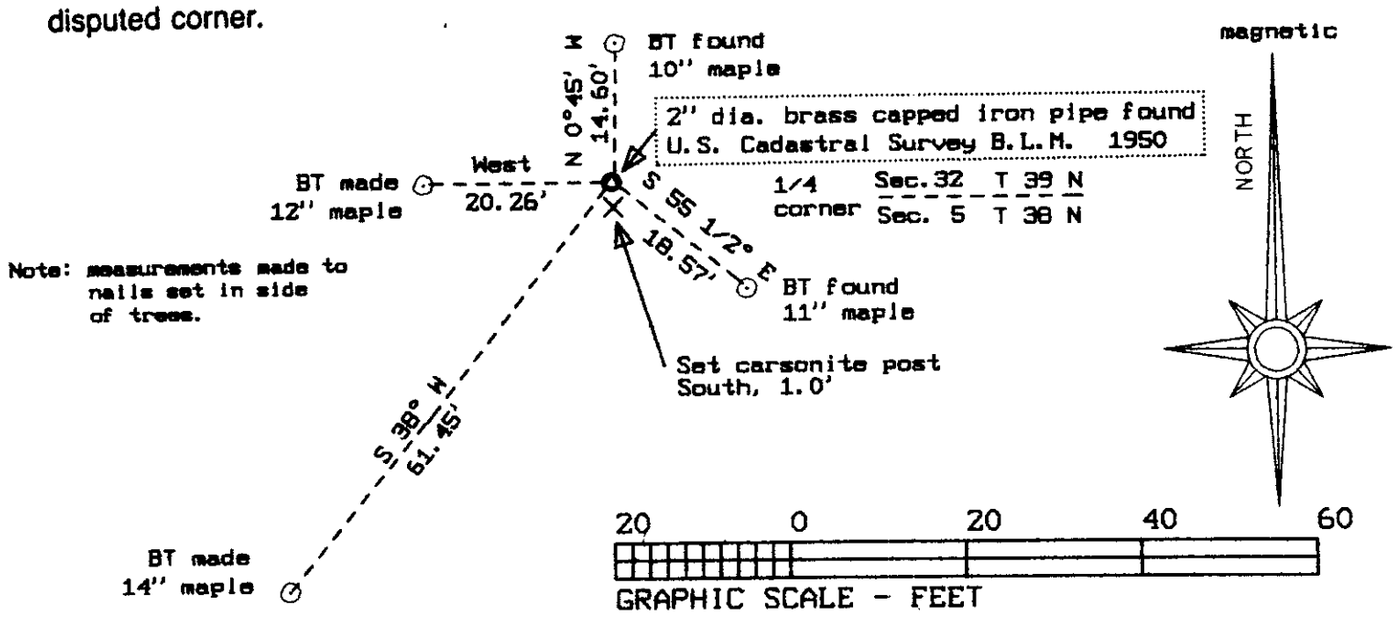

(i) I, Stephen J. Favorite RLS#1616 **(type or print name) certify that the corner location on this record was determined by me or under my direction and control and that this U.S. Public Land Survey Monument Record is correct and complete to the best of my knowledge and belief.**

Stephen J. Favorite 12-29-94

Signature Date

WISCONSIN STEPHEN J. FAVORITE S-1616 EAGLE RIVER, WI LAND SURVEYOR

Index No. Z-7

3909320020