U.S. PUBLIC LAND SURVEY MONUMENT RECORD

Note: This form is intended and designed to fulfill all requirements of Wisconsin Administrative Code, Chapter A-E 7.08 U.S. Public Land Survey Monument Record (3)(a-i).

(a) CORNER LOCATION
Cor. of Secs. 14, 15, 22 & 23
Township 39 North
Range 10 East of the 4th P.M.
Town of Three Lakes
County of Oneida

WISCRS - Oneida County
N: 246,005.43 USft
E: 313,870.72 USft
Datum: NAD 83(2011)
GNSS Method: RTN Direct
GNSS Control: WISCORS VRS

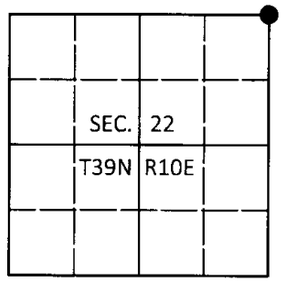

(b) HISTORY OF ORIGINAL CORNER ESTABLISHMENT

Original Surveyor: William Daugherty

Original Accessories:

Date of Survey Commenced: Sept., 1863
Completed: Oct., 1863

tamarack 6" S75°E, 55 lks.
tamarack 8" N42°E, 92 lks.

(b)(f)(g)(h) Description of monument found at this corner and if it was accepted, state all evidence (material, testimonial, occupational, plats, records, other monuments) used as a basis for accepting. If not accepted or if nothing was found, state evidence used as basis for establishing location. If re-established through lost corner proportionate methods, indicate all monuments, distances and directions used to establish. Indicate type of monument and sign post found or set.

October 23, 2006: VCS (Vilas) Map No. C-1884 by Jeffrey Anderson, RLS. 6" sq. concrete monument found.

October 4, 2016: I found and accepted the record monument, a 6" sq. concrete monument. As the monument is located in extremely wet conditions, I was unable to replace it or measure to bearing trees. I established accessories as shown below and found a white vinyl sign post bearing East, 1 ft. dist.

The coordinate value shown has been verified by at least one of the following methods: 1) comparison to a previously GPS determined published value; 2) the value is the average of two or more GPS observations at a markedly different time; 3) one or more distances were measured back to the GPS observed corner from temporary GPS observed offset locations.

(c)(d)(e) Plan view of corner with ties to at least 4 witness monuments. If in disagreement with previously established corner, show the distances between the two corners and also indicate the ties to the disputed.

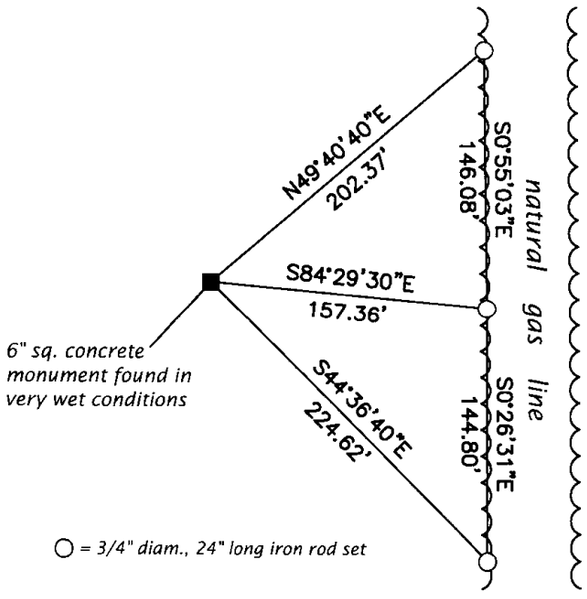

Oneida Co. Grid
1" = 100'

REGISTER OF DEEDS OFFICE
ONEIDA COUNTY
FILED

DEC 28 2016

AT_____O'CLOCK_____M
KYLE J. FRANSON
REGISTER OF DEEDS

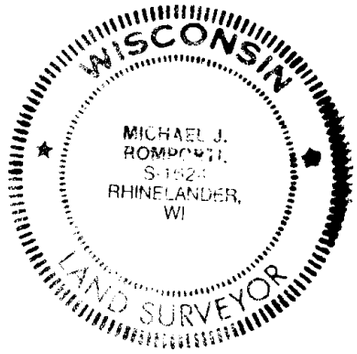

(i) I, Michael J. Romportl, Professional Land Surveyor No. S-1624, hereby certify that the corner location on this record was determined by me or under my direction and control and that this U.S. Public Land Survey Monument Record is correct and complete to the best of my knowledge and belief.

Michael J Romportl 12/23/2016
Signature Date

3910150000 (INDEX NO. N-17)