

State of Wisconsin

County of Oneida } ss.

I Robert E. Bandow, do hereby certify that on the 5th day of July 19 84, I found evidence of the Southwest Section corner of Section 25 Township 39 North, Range 10 East Fourth Principal Meridian, as described hereon; and that from this evidence I established a new monument and accessories as described hereon to perpetuate the original location of this corner.

Resident witnesses:

Michael F. Weber

Eric Zychowski

U.S. Public Land Survey Monument Record

Index No. V-21

History of original corner establishment:

Original corner was established during the course of the subdivision of T 39 N, R 10 E, which was started Sept. 30, 1863 and completed Oct. 7, 1863 by William E. Daurherty, Deputy Surveyor.

Original B.T.'s:


8" Tamarack S 30° W 56 lks.  
8" Spruce N 79° W 43 lks.

Description of corner evidence found:

Found a DNR 2" iron pipe brass cap in the south shoulder of Wykowski Road. Found the following bearing trees in place:  
8" N. Pine N 76° E 179.45' (Measurements are to a nail in the 11" N. Pine S 50° E 160.15' side of the trees.)

Description of monument and accessories I established to perpetuate the original location of this corner.

Blazed and scribed the following new bearing trees:  
4" W. Birch S 77° E 38.65' (Measurements are to a nail Power pole #3910-25130 N 74° W 138.42' in the side of the trees.)

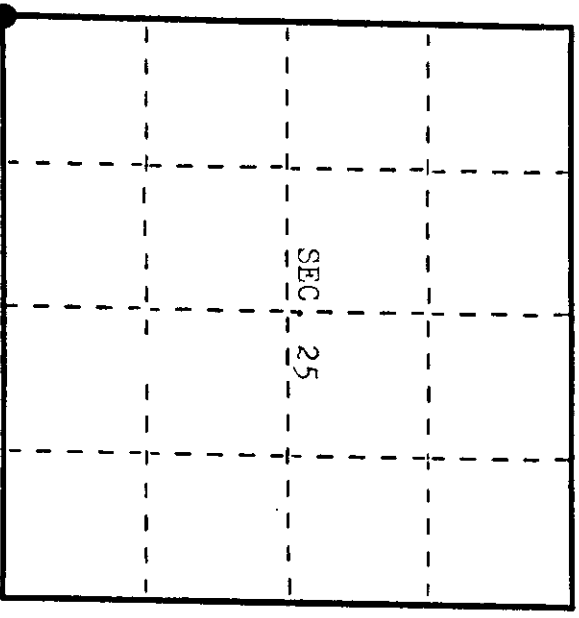

Dated at Eagle River Wis, this 14th day of Sept., 19 84.

Signature: [Signature] Title Registered Land Surveyor Registration No. S-104 (County Surveyor, Registered Land Surveyor, or other duly authorized official)

Office of Register of Deeds, County of Oneida, I hereby certify that the within instrument was filed in this office for record on the 14th day of Sept., 19 84 at 10:00 o'clock A.M.

(Register of Deeds)

By: [Signature] Deputy

3910260000

