U.S. PUBLIC LAND SURVEY MONUMENT RECORD

Note: This form is intended and designed to fulfill all requirements of Wisconsin Administrative Code, Chapter A-E 7.08 U.S Public Land Survey Monument Record (3) (a) (b) (c) (d) (e) (f) (g) (h) (i). An additional sheet may be added if necessary to conform with said requirements.

(a) Corner location: Township 39 North

Range 10 East/West

Town/City/Village THREE LAKES

County ONEIDA

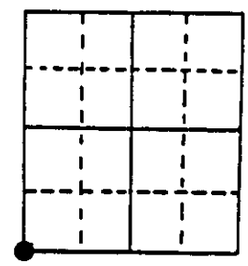

Section 27

(b) (f) (g) (h) Description of monument found at this corner and if it was accepted, state all evidence (material, testimonial, occupational, plats, records, other monuments) used as a basis for accepting. If not accepted or if nothing was found, state evidence used as basis for establishing location. If reestablished through lost corner proportionate methods, indicate all monuments, distances and directions used to establish. Indicate type of monument found or set and sign post.

1863- William Daugherty set wood post.

Original B.T.'s White pine 10" S43°W 12lks.
White pine 10" N35°E 9lks.

1935- Branham (Book 7 P. 3) set wood post to replace original.

New B.T.'s White pine 10" S50°W 10lks.
Jack pine 10" N41°W 60lks.

1948- Branham set iron pipe at corner position. Gives distance between Section corner and pipe set at the West 1/4 corner to be 2724 feet. We measure 2723.13 feet.

1998- Replaced found 2" diameter iron pipe with a 2-1/2" X 30" (over)

(c) (d) (e) Plan view of corner with ties to at least 4 witness monuments. If in disagreement with previously established corner, show the distances between the two corners and also indicate the ties to the disputed corner.

Note: All measurements are taken to aluminum nail at the base of tree.

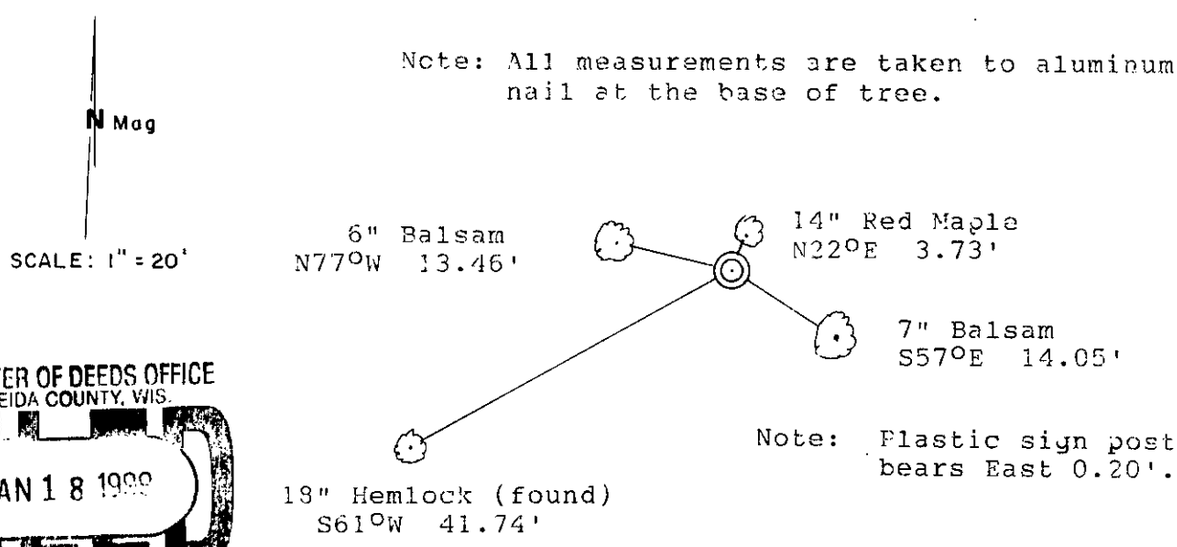

Note: Plastic sign post bears East 0.20'.

REGISTER OF DEEDS OFFICE
ONEIDA COUNTY, WIS.
JAN 18 1999

(i) I, KIP W. SODER R.L.S. #1731 (type or print name) certify that the corner location on this record was determined by me or under my direction and control and that this U.S. Public Land Survey Monument Record is correct and complete to the best of my knowledge and belief.

Kip W. Soder — Signature

Jan 12, 1999 — Date

KIP W. SODER S-1731 THREE LAKES, WI
LAND SURVEYOR
WISCONSIN

3910280000
Stamp

Index No. V 13

Oneida County aluminum capped monument stamped to identify corner. Corner found had Oneida County plastic sign post 2" East and remains of recent air photo marker were at corner position. Found B.T.-Hemlock 18" S61°W 41.74'. Made new B.T.'S and plastic sign post bears East 0.20 feet from corner.