

This form is intended to fulfill the requirements of Chapter A-E7.08 (3)(a) thru (i) U.S. Public Land Survey Monument Location Record, Wisconsin Administrative Code. Use the reverse side of form for continuation.

U.S. PUBLIC LAND SURVEY MONUMENT LOCATION RECORD

USPLS CORNER: WEST 1/4 SECTION: 29 TOWNSHIP: 39 NORTH RANGE: 10 EAST
 NAME OF WATERWAY FOR M.C. CORNER : N/A SECTION LINE: N/A
 (CITY)(VILLAGE)(TOWN) OF: SUGAR CAMP COUNTY OF: ONEIDA

Description of monument found or placed and all other evidence used as the basis for monument location; including monuments and measurements required if the corner location was reestablished by lost corner proportionate methods. Also indicate name of the original surveyor, original survey date and the corner monument, bearing trees, witness or other reference monuments established, including measured bearing and distance ties, from available survey records.

Found and accepted an old plumb and secure blue painted 1.5" dia. iron pipe with a 3" square by 1/4" thick steel plate cap 20" above grade as set and stamped by Ripco in 1953/54 in place of an old scribed cedar post found at the corner. I left in place for new ties. Also found an old 14" Py BT S45°W 20" to blaze face with faint scribing, upper blaze shut and painted blue many years ago and a square aluminum Ripco section location tag nailed to upper face.

Corner also previously located by GPS control survey per Oneida County survey records at UTM: 322969 dE/5078686 dN.


This corner is in a wooded wetland area about 375' North of an unimproved roadway bearing S25°E, which I flagged as a North/South line between at frequent intervals and terminates at the woods road about 0.7 miles by vehicle northeasterly from junction with Ripco Road at 0.75 miles North of Columbus Lake Road, to aid future recovery.

In October 1863, William E. Daugherty/GLO set a wood post as the original corner and noted OBTs: a 12" Cedar S50°E 14 links and a 10" Cedar N45°W 19 links; all are now obliterated.

This recovery completed August 5, 2004; there were no direct witnesses.

Plan view map of monument location with bearing and distance ties to a minimum of four(4) described witness or reference monuments of concrete, natural stone, iron, live bearing trees or equivalent material. If applicable, also show a minimum of two(2) bearing and distance ties to any other monument found and not accepted; including the bearing and distance from the accepted monument.

NORTH

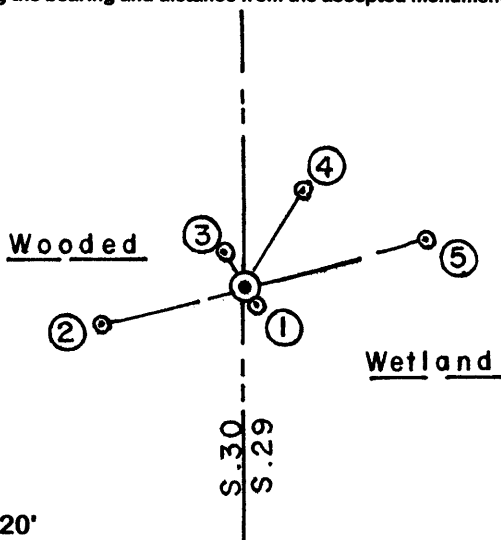

SCALE: 1" = 20'

Unless otherwise indicated, all bearing tree ties are to a .25" dia. by 2.5" long PK nail with a 1.25" dia. steel washer driven into unblazed right face and a .25" dia. by 2.5" long PK nail with a 2" dia. steel washer stamped BT is also driven into unblazed face of bearing tree at DBH; the basis for measured bearings is by compass to nearest degree and all tie distances are measured horizontal by steel tape corrected to nearest 1/100th feet at standard temperature of 68° F.


WITNESS MONUMENT TIES:

- ① New 5" Ash BT S55°E 2.13'.
- ② New 10" Ash BT S75°W 15.33'.
- ③ New 4.5" Ash N30°W 4.21'.
- ④ New 5.5" Ash N30°E 11.71'.
- ⑤ New 6" Cedar BT N74°E 19.07'.

I found a standard white poly 'T' marker post 5" East of the corner monument.

I flagged monument, 'T' post and all new BTs blaze orange & painted the old BT blazes orange.


RLS SEAL:

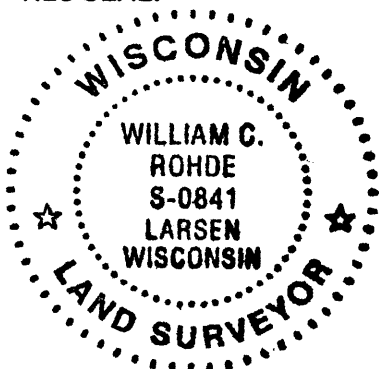

LAND SURVEYOR CERTIFICATE:

I, William C. Rohde, hereby certify that I am duly licensed as a Professional Land Surveyor in the State of Wisconsin; that this USPLS monument location was determined by me and/or under my direct supervision and control; and that this U.S. Public Land Survey Monument Location Record is true and correct to the best of my knowledge and belief.

Signed: *William C. Rohde*
 William C. Rohde RLS 841

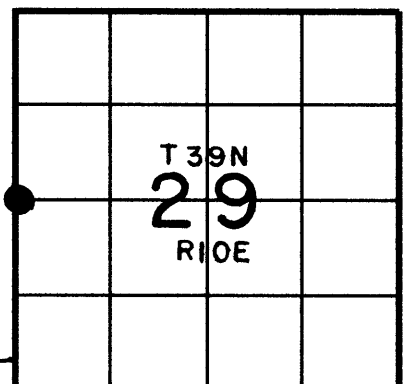

SECTION LOCATION MAP
 INDEX NO. 15

Date Signed: September 4, 2004

3910302000