U.S. PUBLIC LAND SURVEY MONUMENT RECORD

Note: This form is intended and designed to fulfill all requirements of Wisconsin Administrative Code, Chapter A-E 7.08 U.S Public Land Survey Monument Record (3) (a) (b) (c) (d) (e) (f) (g) (h) (i). An additional sheet may be added if necessary to conform with said requirements.

(a) Corner location: Township 39 North

Range 10 East

Town/City/Village Sugar Camp

County Oneida

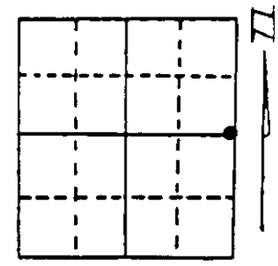

Section 31

(b) (f) (g) (h) Description of monument found at this corner and if it was accepted, state all evidence (material, testimonial, occupational, plats, records, other monuments) used as a basis for accepting. If not accepted or if nothing was found, state evidence used as basis for establishing location. If reestablished through lost corner proportionate methods, indicate all monuments, distances and directions used to establish. Indicate type of monument found or set and sign post.

1863-William E. Daugherty set post 8" Birch South 554 degrees West 14 links, 10" Birch North 29 degrees East 3 links

1948-Frosty Wincentsen found cross in stone monument marked ¼ 25 links South of C/L of East West Road

1976-James Rein found 1" iron pipe and 3"x6"x12" etched stone BTs R.R. spike in 6" White Birch South 84 degrees West 45.1' R.R. spike in power pole North 3 degrees East 44.7'

1993-William E. Bandow found iron pipe. It remains in place. Witnessed as shown below:

(c) (d) (e) Plan view of corner with ties to at least 4 witness monuments. If in disagreement with previously established corner, show the distances between the two corners and also indicate the ties to the disputed corner.

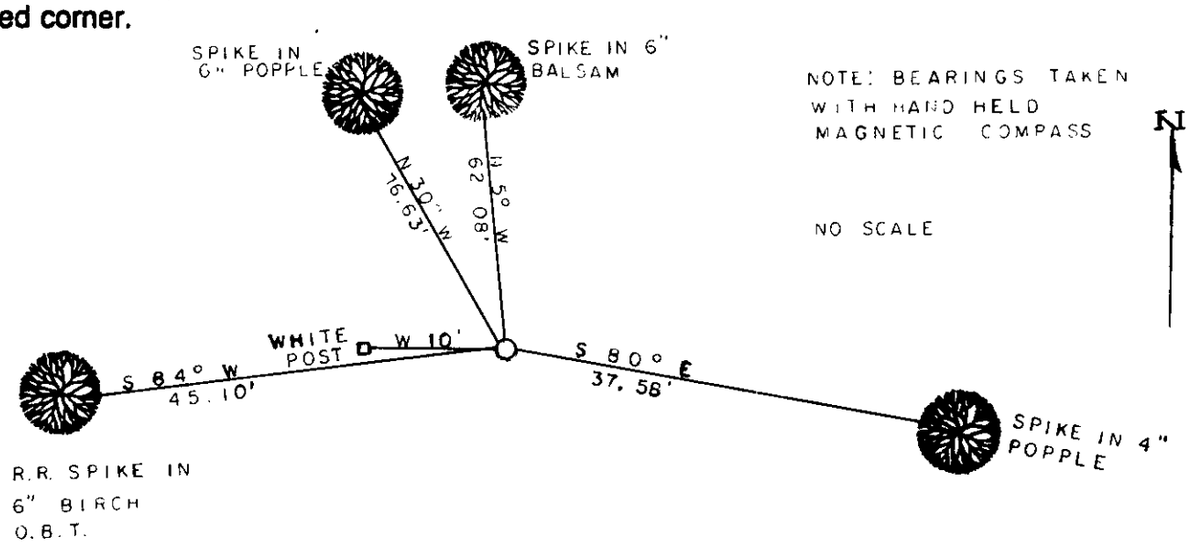

(i) I, William E. Bandow (type or print name) certify that the corner location on this record was determined by me or under my direction and control and that this U.S. Public Land Survey Monument Record is correct and complete to the best of my knowledge and belief.

William E Bandow 3-11-93

Signature Date

WISCONSIN WILLIAM E. BANDOW S. 1882 RHINELANDER WIS. LAND SURVEYOR

3910312000

Stamp

Index No. X-5